

SURVEY & REMONUMENTATION

PK. 11/7/97

APR 07 1998

LAND CORNER RECORDATION CERTIFICATE
Filing Requirement of Act 74, Mich. P.A. 1970
 Chippewa County Remonumentation Corner


SECTION
 For corners in

Chippewa County	Located in:	Corner Code #
1. Public Land Survey	T45N R2W	F-9
	T R	
	T R	
	T R	
2. Property Controlling in Section	S T R	
	S T R	
3. Miscellaneous Property in Sec.	S T R	
	S T R	
4. Lot No.	Recorded Plat	
5. Private Claims		

\$7.00 LAND CORNER
 \$2.00 MSSR
 6 Mar 1998 1:47:04 PM Receipt #6451
 RECEIVED FOR RECORD
 CHIPPEWA COUNTY - STATE OF MICHIGAN
 SHARON H. KENNEDY, REGISTER OF DEEDS

BOOK **10** PAGE **184**

Register of Deeds Stamp & File Number

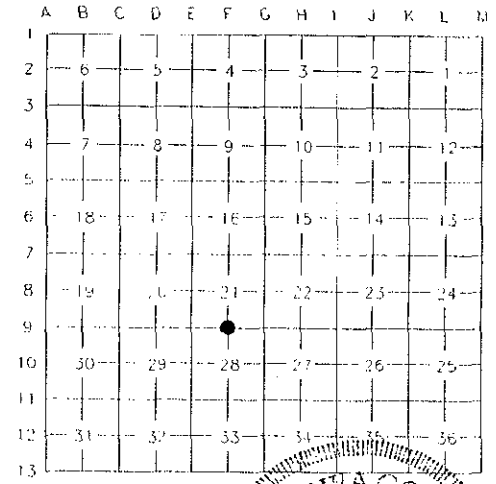

I, Keith R. Waters, in a field survey on October 31, 1997, do hereby state that under requirements of P.A. 74, Michigan P.A. of 1970, the corner points mentioned in lines 1 and 2 above were in conformance with regulations and rules therefore as required in the current manual of survey instructions of the United States Department of the Interior, Bureau of Land Management or by a decree of a Court of Law and/or that the corner points mentioned in lines 3, 4 and 5 above were in conformance with the rules of the Michigan Board of Land Surveyors or by a Decree of a Court of Law; established, re-established, monumented, recovered, found as expressed below:

NOTE: Not more than 2 corners, all in the same town and range, may be recorded on this certificate.

A. Description of original monument and accessories and/or subsequent restoration:

F-9 1/4 Corner common to Sections 21 & 28, Town 45 North, Range 2 West

1849 - Original corner (spruce post) was established by Harvey Mellen, D.S.
 Witnesses: Tamarack 14, S83°E 39 links
 Tamarack 12, N11°E 50 links

1913 - Chippewa County Surveyor Frederick H. Brown notes for Section 21 indicate that this corner was in an open burn area and that he found no evidence of the original corner. His sketch shows the corner midway between section corners 2614 feet east and 2614 feet west.

B. Description of corner evidence found and/or method applied in restoring or reestablishing corner:


This corner is being reestablished as part of the Chippewa County Remonumentation Program. Found no evidence of the corner. The distance between section corners east and west is within 1.1 feet of that as shown in above mentioned County Surveyor notes. Reestablished corner by single proportionate measurement midway on line between said section corners. Corner location falls in the centerline of an east-west asphalt road.

C. Description of monument for corner and accessories established to perpetuate locating the position of the corner:

Placed a 1/4" x 24" rebar with a plastic Chippewa County Remonumentation cap at the corner location, which falls in the centerline of an east-west asphalt road (Ploegstra Road), at a ditch line north and south.
 Witnesses:

- Corner Fence Post (fence line on east side of ditch), N15°E 40.97'
- Corner Fence Post (fence line on west side of ditch), S38°W 41.22'
- Center of Top of Gas Pipeline Marker, N24°W 43.24'
- Fence Post, N75°E 108.03'

Note: Distances to fence posts are to a nail/tag #33142 in the side.
 Bearings are compass bearings corrected for declination.

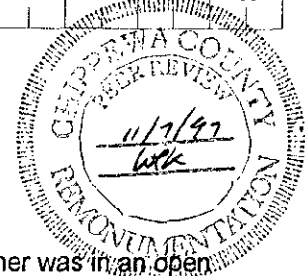

Signed by Keith R. Waters

Date 12-30-97

Surveyor's Michigan License No. 33142