

**SURVEY &
REMONUMENTATION**

PK: 11/13/97 ✓

APR 07 1998

LAND CORNER RECORDATION CERTIFICATE
Filing Requirement of Act 74, Mich. P.A. 1970
Chippewa County Remonumentation Corner


For corners in **SECTION**

Chippewa County	Located in:	Corner Code #
1. Public Land Survey	T45N R2W	G-6
	T R	
	T R	
	T R	
2. Property Controlling in Section	S T R	
	S T R	
3. Miscellaneous Property in Sec.	S T R	
	S T R	
4. Lot No. , Recorded Plat		
5. Private Claims		

\$7.00 LAND CORNER
\$2.00 NSSR
6 Mar 1998 1:51:53 PM Receipt #6451
RECEIVED FOR RECORD
CHIPPewa COUNTY - STATE OF MICHIGAN
SHARON H. KENNEDY, REGISTER OF DEEDS

BOOK **10** PAGE **186**

Register of Deeds Stamp & File Number

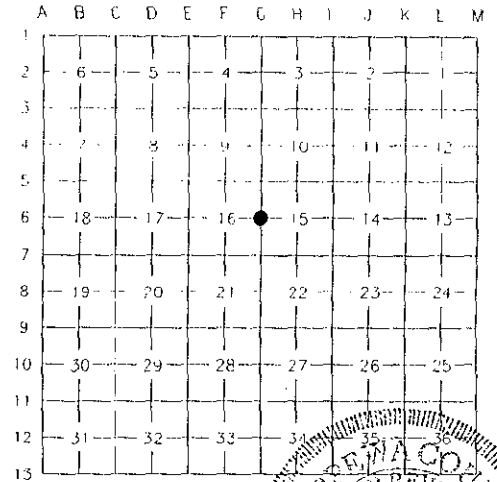

I, Keith R. Waters, in a field survey on November 4, 1997, do hereby state that under requirements of P.A. 74, Michigan P.A. of 1970, the corner points mentioned in lines 1 and 2 above were in conformance with regulations and rules therefore as required in the current manual of survey instructions of the United States Department of the Interior, Bureau of Land Management or by a decree of a Court of Law and /or that the corner points mentioned in lines 3, 4 and 5 above were in conformance with the rules of the Michigan Board of Land Surveyors or by a Decree of a Court of Law, established, re-established, monumented, recovered, found as expressed below:

NOTE: Not more than 2 corners, all in the same town and range, may be recorded on this certificate.

A. Description of original monument and accessories and/or subsequent restoration:

G-6 1/4 Corner common to Sections 15 & 16, Town 45 North, Range 2 West

- 1849 - Original corner (sugar maple post) was established by Harvey Mellen, D.S.
Witnesses: Lynn 12, S50°E 11 links - Ironwood 6, N22°W 7 links
- 1908 - Chippewa County Surveyor Frederick H. Brown notes for Section 16 state "could not find any 1/4 post on the east side of Section 16." A distance of 5219 feet is shown between original section corners G-5 and G-7.
- 1970 - Chippewa County Road Commission section corner record, liber 3, page 189. Replaced original corner from metal hub to 1" x 18" iron pipe. Witnesses: 4" Maple, S55°E 63.70' - 10" Maple, SW 65.50'
- 1979 - Certificate of Survey, liber 2 of Surveys, page 100, Thomas Kelly, RLS 24599. Found 1" pipe.
Witnesses: 7" Maple, S61°E 58.50' - 24" Maple, S80°W 59.65' - 12" Poplar, N77°E 62.00'
- 1989 - Certificate of Survey, liber 545, page 20, James H. Granger, RLS 16041. Found 1" pipe. Witnesses:
8" Maple, S49°E 58.50' - 16" Maple, S57°W 65.38' - 12" Maple, WEST 57.66' - 6" Poplar, N68°E 62.18'
- 1991 - LCRC liber 7, page 374, Stephan J. Szyzkoski, P.S. 33986. Found and accepted 1" pipe. Witnesses:
12" Maple, N86°W 57.7' - 12" Maple, S60°W 65.4' - 7" Maple, S50°E 58.55' - 7" White Birch, N26°E 84.6'

B. Description of corner evidence found and/or method applied in restoring or reestablishing corner:

This corner is being perpetuated as part of the Chippewa County Remonumentation Program.
The 1" iron pipe called for in the above mentioned documents was destroyed by road construction in 1996.
Reestablished the position using previous traverse information and found bearing trees.

C. Description of monument for corner and accessories established to perpetuate locating the position of the corner:

Placed a 1/2" x 24" rebar with a plastic Chippewa County Remonumentation cap the corner location, which falls 1.7 feet west of the centerline of Bound Road, north of the intersection of Thompson Road.
Witnesses:

- Nail/tag #16041 in 16" Sugar Maple, S57°W 65.24'
- Nail/tag #24599 in 8" Sugar Maple, S55°E 58.55'
- Nail/tag #33142 in 12" Sugar Maple, S88°W 57.58'
- Nail/tag #33142 in Power Pole, S24°W 98.93'

Note: Bearings are compass bearings corrected for declination.
Trees are blazed and painted.



Signed by Keith R. Waters

Date 12-30-97

Surveyor's Michigan License No. 33142