

APR 26 1995

CHIPPEWA COUNTY REMONUMENTATION CORNER

COMMISSION

LAND CORNER RECORDATION CERTIFICATE

Filing Requirement of Act 74, Mich. P.A. 1970


For corners in
Chippewa

(County)

Located In:

Corner Code #

- 1. Public Land Survey T 45NR 2W G-13
T _____ R _____
T _____ R _____
- 2. Property Controlling S _____ T _____ R _____
in Section S _____ T _____ R _____
- 3. Miscellaneous S _____ T _____ R _____
Property in Sec. S _____ T _____ R _____
- 4. Lot No. _____, Recorded Plat _____
- 5. Private Claims _____

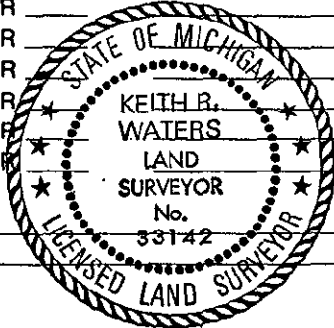

\$ 7.00 LAND CORNER
\$ 2.00 MSSR
19 JAN 95 4:21 P.M. RECEIPT# 2266
RECEIVED FOR RECORD
CHIPPEWA COUNTY - STATE OF MICHIGAN
REGISTERED CORNER STATION

	A	B	C	D	E	F	G	H	I	J	K	L	M
2	6	5	4	3	2	1							
3													
4	7	8	9	10	11	12							
5													
6	16	17	18	15	14	13							
7													
8	19	20	21	22	23	24							
9													
10	30	29	28	27	26	25							
11													
12	31	32	33	34	35	36							
13													

I, Keith R. Waters in a field survey on November 18, 19 94, do hereby certify that under requirements of P.A. 74, Michigan P.A. of 1970, the corner points mentioned in lines 1 and 2 above were in conformance with regulations and rules therefore as required in the current manual of survey instructions of the United States Department of the Interior, Bureau of Land Management or by a decree of a Court of Law and/or that the corner points mentioned in lines 3, 4 and 5 above were in conformance with the rules of the Michigan Board of Land Surveyors or by a Decree of a Court of Law; established, re-established, monumented, re-monumented, recovered, found as expressed below:

NOTE: Not more than 4 corners, all in the same town and range, may be recorded on this certificate.

A. Description of original monument and accessories and/or subsequent restoration:

G-13 Corner Common to Sections 33 & 34, on the South Boundary of 45N, R2W. (Standard Corner on Township Line)
Original ties to post: Spruce 13, N35°E 13 links Spruce 7, N75°W 13 links. 1959 - Highway Department, as recorded in liber 2, page 235, liber 2, page 238, and liber 3, page 229, Chippewa County corner records. Corner is called out as a 1" iron bolt, a 1" iron pin, and a 1" iron bolt, respectively. Various fence posts and utility poles as shown as witnesses. It does not appear that double corners were recognized.

B. Description of corner evidence found and/or method applied in restoring or reestablishing corner:

G-13 (T45N, R2W)
This corner is being re-established as part of the Chippewa County Remonumentation Program.
Found a 1" iron bolt as called for in previous Highway Department records. 1" bolt works well with other corners and occupation on the township line east and west as the closing corner for Sections 3 & 4, T44N, R2W. Bolt has been used in surveys in both Sections 3 & 4 as the closing corner. Re-established standard corner for Sections 33 & 34, T45N, R2W at record GLO distance (13.20 feet) west of 1" bolt, on extension of line between said bolt at closing corner and established standard corner one mile east. Corner falls in a ditch inside the right-of-way fence on the east side of Highway I-75.

C. Description of monument for corner and accessories established to perpetuate locating the position of the corner:

G-13 (T45N, R2W)
Corner is 3/4" x 24" rebar in a ditch inside the right-of-way fence on the east side of Highway I-75. Witnesses:

- Power Pole, S32°W 290.71'
- Fence Post, N61°E 68.07'
- Fence Post, S20°W 84.47'
- Power Pole, N85°E 287.33'
- 3/4" Rebar w/aluminum cap @ Closing Corner, EAST 13.20'

Note: Distances to poles and fence posts are to a nail and tag in the side. Bearings are compass bearings corrected for declination.

Signed by Keith R. Waters

Date 12-23-94

Surveyor's Michigan License No. 33142

