SURVEY &
REMONUMENTATION

APR 07 1998

SECTION

LAND CORNER RECORDATION CERTIFICATE
Filing Requirement of Act 74, Mich. P.A. 1970
Chippewa County Remonumentation Corner

For corners in

Chippewa County	Located in:			Corner Code #
1. Public Land Survey		T45N	R2W	H-9
		T	R	
		T	R	
		T	R	
2. Property Controlling	S	T	R	
in Section	S	T	R	
3. Miscellaneous	S	T	R	
Property in Sec.	S	T	R	

4. Lot No. , Recorded Plat
5. Private Claims

$7.00 LAND CORNER
$2.00 MSSR
6 Mar 1998 1:57:23 PM Receipt #6451
RECEIVED FOR RECORD
CHIPPEWA COUNTY - STATE OF MICHIGAN
SHARON H. KENNEDY, REGISTER OF DEEDS

BOOK 10 PAGE 194

Register of Deeds Stamp & File Number

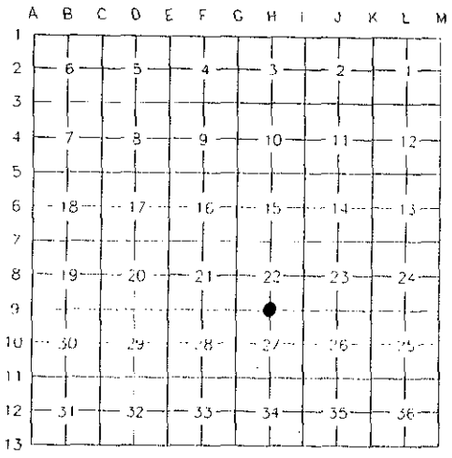

I, Keith R. Waters, in a field survey on November 3, 1997, do hereby state that under requirements of P.A. 74, Michigan P.A. of 1970, the corner points mentioned in lines 1 and 2 above were in conformance with regulations and rules therefore as required in the current manual of survey instructions of the United States Department of the Interior, Bureau of Land Management or by a decree of a Court of Law and /or that the corner points mentioned in lines 3, 4 and 5 above were in conformance with the rules of the Michigan Board of Land Surveyors or by a Decree of a Court of Law; established, re-established, monumented, recovered, found as expressed below:

NOTE: Not more than 2 corners, all in the same town and range, may be recorded on this certificate.

A. Description of original monument and accessories and/or subsequent restoration:

H-9 ¼ Corner common to Sections 22 & 27, Town 45 North, Range 2 West

1849 - Original corner (spruce post) was established by Harvey Mellen, D.S.
Witnesses: White Pine 12, S68°E 24 links
Tamarack 6, N82°W 29 links

Found no evidence of subsequent restoration of this corner.

CHIPPEWA COUNTY PEER REVIEW 11/7/97 REMONUMENTATION

B. Description of corner evidence found and/or method applied in restoring or reestablishing corner:

This corner is being reestablished as part of the Chippewa County Remonumentation Program. Found no evidence of this corner or its accessories. Reestablished corner by single proportionate measurement midway on line between section corners 2633.32 feet east and 2633.32 feet west.

C. Description of monument for corner and accessories established to perpetuate locating the position of the corner:

Placed a ¾" x 24" rebar with a plastic Chippewa County Remonumentation cap at the corner location, which falls approximately 5 feet south of the centerline of east-west asphalt road (Ploegstra Road).
Witnesses:

8" White Pine, S75°W 118.86'
5" White Pine, S70°W 85.00'
4" Tamarack, S53°W 56.93'
8" White Pine, S15°W 82.36'

Note: Distances are to a nail/tag #33142 in the side of the tree.
Trees are blazed and painted.
Bearings are compass bearings corrected for declination.

STATE OF MICHIGAN
KEITH R. WATERS
PROFESSIONAL SURVEYOR
No. 33142
LICENSED PROFESSIONAL SURVEYOR

Signed by Keith R. Waters Date 12-30-97

Surveyor's Michigan License No. 33142

FORM APPROVED BY MICHIGAN STATE BOARD OF PROFESSIONAL SURVEYORS, JAN. 28, 1971
REVISED MAY 14, 1975
REVISED JAN., 1983
REVISED OCT., 1995

BOOK 10 PAGE 194

LCRC T45N R2W H-9