

SURVEY & REMONUMENTATION

APR 26 1995

CHIPPEWA COUNTY REMONUMENTATION CORNER

COMMISSION

LAND CORNER RECORDATION CERTIFICATE
Filing Requirement of Act 74, Mich. P.A. 1970


For corners in Chippewa

(County)

Located In:

Corner Code I-13

- 1. Public Land Survey T 45N R 2W I-13
- T _____ R _____
- T _____ R _____
- T _____ R _____
- 2. Property Controlling S _____ T _____ R _____
- in Section S _____ T _____ R _____
- 3. Miscellaneous S _____ T _____ R _____
- Property in Sec. S _____ T _____ R _____
- 4. Lot No. _____, Recorded Plat _____
- 5. Private Claims _____

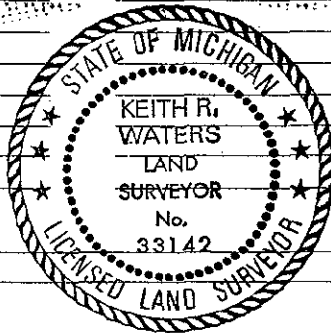

\$ 7.00 LAND CORNER
\$ 2.00 MSSR
5 DEC 94 12:28 P.M. RECEIPT# 1519
RECEIVED FOR RECORD
CHIPPEWA COUNTY - STATE OF MICHIGAN
SHARON H. KENNEDY, REGISTER OF DEEDS
Register of Deeds Stamp & File Number

	A	B	C	D	E	F	G	H	I	J	K	L	M
2	6	5	4	3	2	1							
3													
4	7	8	9	10	11	12							
5													
6	18	17	16	15	14	13							
7													
8	19	20	21	22	23	24							
9													
10	30	29	28	27	26	25							
11													
12	31	32	33	34	35	36							
13													

I, Keith R. Waters in a field survey on January 4, 1994, do hereby certify that under requirements of P.A. 74, Michigan P.A. of 1970, the corner points mentioned in lines 1 and 2 above were in conformance with regulations and rules therefore as required in the current manual of survey instructions of the United States Department of the Interior, Bureau of Land Management or by a decree of a Court of Law and/or that the corner points mentioned in lines 3, 4 and 5 above were in conformance with the rules of the Michigan Board of Land Surveyors or by a Decree of a Court of Law; established, re-established, monumented, re-monumented, recovered, found as expressed below:

NOTE: Not more than 4 corners, all in the same town and range, may be recorded on this certificate.

A. Description of original monument and accessories and/or subsequent restoration:

I-13 Corner Common to Sections 34 & 35, on South Boundary of T45N, R2W (Standard Corner on Township Line)
Original ties to post: Hemlock 8, N43°E 16 links
Fir 8, N06°W 18 links
1991 - Corner is shown on a survey drawing by Ronald R. Bischer, P.S. 22428, as a found 1" pipe, with the following witnesses: 4" Cherry, S36°W 16.7'
Power Pole, N60°W 74.6' 18" Spruce, S58°E 19.2' 1/2" Rod, EAST 32.34' (Closing Corner)


B. Description of corner evidence found and/or method applied in restoring or reestablishing corner:

I-13 (T45N, R2W)
This corner is being perpetuated as part of the Chippewa County Remonumentation Program.
Found a 1" pipe on west side of north-south road, as shown on above mentioned survey drawing. Two witness objects (cherry and power pole) are still intact. Accepted corner as found and established new witness objects. Corner is approximately 100 feet south of the centerline of east-west gravel road (Aho Road). Corner is 32.25 feet west of a set iron at the closing corner common to Sections 2 and 3, T44N, R2W.

C. Description of monument for corner and accessories established to perpetuate locating the position of the corner:

I-13 (T45N, R2W)
Corner is 1" iron pipe on the west side of a north-south dirt road approximately 100 feet south of the centerline of Aho Road. Witnesses:
30" White Pine, N58°E 63.36'
Power Pole, N19°E 124.91'
8" Spruce, S70°E 62.70'
Power Pole (RU2-96A-17), N59°W 74.18'

Note: Distances are to a nail and tag in the side of the witness object. Trees are blazed and painted. Bearings are compass bearings corrected for declination. Distances are measured with EDM.

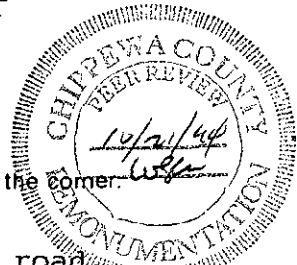

Signed by Keith R. Waters Date 10-25-94
Surveyor's Michigan License No. 33142