

APR 26 1995

CHIPPEWA COUNTY REMONUMENTATION CORNER

COMMISSION

LAND CORNER RECORDATION CERTIFICATE
Filing Requirement of Act 74, Mich. P.A. 1970

For corners in Chippewa

(County)	Located In:	Corner Code #
1. Public Land Survey	T <u>45N</u> R <u>2W</u>	<u>J-13</u>
	T _____ R _____	
	T _____ R _____	
	T _____ R _____	
2. Property Controlling In Section	S _____ T _____ R _____	
	S _____ T _____ R _____	
3. Miscellaneous Property in Sec.	S _____ T _____ R _____	
	S _____ T _____ R _____	
4. Lot No. _____, Recorded Plat _____		
5. Private Claims _____		



\$ 7.00 LAND CORNER
\$ 2.00 HSSR
19 JAN 95 4:22 P.M. RECEIPT# 2266
RECEIVED FOR RECORD
CHIPPEWA COUNTY - STATE OF MICHIGAN
SHARON H. KENNEDY, REGISTER OF DEEDS
Register of Deeds Stamp & File Number

	A	B	C	D	E	F	G	H	I	J	K	L	M
2	6	5	4	3	2	1							
3													
4	7	8	9	10	11	12							
5													
6	18	17	16	15	14	13							
7													
8	19	20	21	22	23	24							
9													
10	30	29	28	27	26	25							
11													
12	31	32	33	34	35	36							
13													

I, Keith R. Waters in a field survey on December 12, 1994, do hereby certify that under requirements of P.A. 74, Michigan P.A. of 1970, the corner points mentioned in lines 1 and 2 above were in conformance with regulations and rules therefore as required in the current manual of survey instructions of the United States Department of the Interior, Bureau of Land Management or by a decree of a Court of Law and/or that the corner points mentioned in lines 3, 4 and 5 above were in conformance with the rules of the Michigan Board of Land Surveyors or by a Decree of a Court of Law; established, re-established, monumented, re-monumented, recovered, found as expressed below:

NOTE: Not more than 4 corners, all in the same town and range, may be recorded on this certificate.

A. Description of original monument and accessories and/or subsequent restoration:

J-13 South 1/4 Corner of Section 35, T45N, R2W.

Original ties to post: Fir 6, N82°E 13 links
Pine 36, N73°W 22 links

1991 - Corner is shown on a survey drawing by Ronald Bischer, P.S. 22428, as a 1/2" rod 16.17 feet east of the north 1/4 corner of Section 2, T44N, R2W. Corner is shown as being mid-way between common section corner 2635.00 feet east and standard section section corner 2635.00 feet west.

B. Description of corner evidence found and/or method applied in restoring or reestablishing corner:

J-13 (T45N, R2W)

This corner is being perpetuated as part of the Chippewa County Remonumentation Program.

Found a 1/2" iron with a plastic cap #22428 on township line mid-way between common section corner to the east and standard section corner to the west, as shown on above mentioned survey drawing. Corner is approximately 137 feet south of the centerline of an east-west gravel road (Aho Road), near a bend to the south in said road. Accepted corner as found and established witness objects.


C. Description of monument for corner and accessories established to perpetuate locating the position of the corner:

J-13 (T45N, R2W)

Corner is a 1/2" iron with plastic cap #22428, approximately 137 feet south of the centerline of east-west gravel road (Aho Road). Witnesses:

- 22" Spruce, N82°E 22.69'
- 16" Spruce, N51°E 27.13'
- 12" Spruce, N34°W 36.44'
- 21" Spruce, N84°W 57.81'
- 1/2" Iron w/cap #22428 @ North
- 1/4 Cor. Sec. 2, EAST 16.17'

Note: Distances to trees are to a nail and tag in the side. Trees are blazed and painted. Bearings are compass bearings corrected for declination.

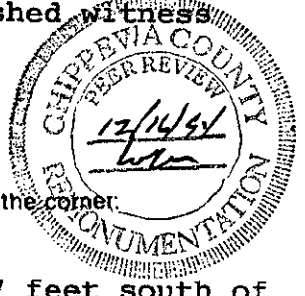

Signed by Keith R. Waters

Date 12-23-94

Surveyor's Michigan License No. 33142