

MAR 27 1996

CHIPPEWA COUNTY REMONUMENTATION CORNER

LAND CORNER RECORDATION CERTIFICATE
Filing Requirement of Act 74, Mich. P.A. 1970

For corners in

Chippewa
(County)

Located In:

Corner Code #

1. Public Land Survey

T46N R2W

K-13 Same

T45N R2W

K-1 Corner

T R

T R

2. Property Controlling
in Section

S T R

S T R

3. Miscellaneous
Property in Sec.

S T R

S T R

4. Lot No. , Recorded Plat

5. Private Claims

\$ 7.00 LAND CORNER

\$ 2.00 MSSR

29 FEB 96 9:35 A.M. RECEIPT# 462

RECEIVED FOR RECORD


CHIPPEWA COUNTY - STATE OF MICHIGAN

SHARON H. KENNEDY, REGISTER OF DEEDS

Register of Deeds Stamp & File Number

I, Larry R. Rogers, in a field survey on Oct. 10, 1995 do hereby state that under requirements of P.A. 74, Michigan P.A. of 1970, the corner points mentioned in lines 1 and 2 above were in conformance with regulations and rules therefore as required in the current manual of survey instructions of the United States Department of the Interior, Bureau of Land Management or by a Decree of a Court of Law and/or that the corner points mentioned in lines 3, 4 and 5 above were in conformance with the rules of the Michigan Board of Land Surveyors or by a Decree of a Court of Law; established or re-established monuments recovered, found as expressed below:

NOTE: Not more than 2 corners, all in the same town and range, may be recorded on this certificate.

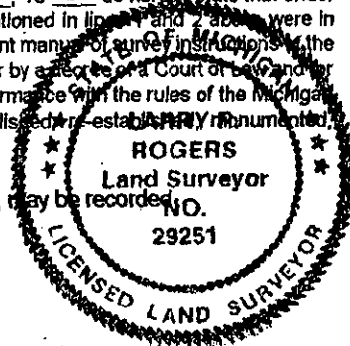

Grid with columns A-L and rows 1-13. Contains handwritten notes '12/1/95' and '16'.

A. Description of original monument and accessories and/or subsequent restoration:

(K-13) Southwest Corner of Section 36, T46N, R2W

Nov 1840: Austin Burt "set post corner of Section 35 and 36 with following witnesses:
6" Cedar N51E 3 links 14" Pine N59W 14 links

Nov 1991: Stephan Szyszkoski, P.S. 33986. Corner recorded in Liber 7, Page 375 of the Chippewa County Corner Records. Found and accepted concrete monument referenced in early County Surveyor records.

Ties:

Nail in Power Pole S41°W 40.48' X in North end CMP N68°E 34.45'

Stop Sign S75°W 38.7' Nail in Power Pole N32°W 39.06'

B. Description of corner evidence found and/or method applied in restoring or reestablishing corner:

(K-13) This corner is being perpetuated as part of the Chippewa County Remonumentation Program.

Found concrete monument with small gauge wire, 12" below grade as set by County Surveyor and previously recorded by S. Szyszkoski. Three witnesses match well - CMP not checked. Accepted monument as found and established two new witnesses.

Description of monument for corner and accessories established to perpetuate locating the position of the corner:

(K-13) Corner is a concrete monument with small gauge wire, 12" below grade of 12 Mile Road (gravel), on centerline of 12 Mile Road and 2.6 feet West of centerline of Kinross Road.

Witnesses: 12" Spruce N39°E 73.98'
Utility Pole (DR4/75/67M) N33°W 39.90'
Stop Sign S71°W 37.65'
Utility Pole S39°W 39.86'
9" Spruce S61°E 119.93'



Witnessed by [Signature]

Date 25 DEC 1995

Surveyor's Michigan License No. 29251

NOTE: All bearings are compass bearings corrected for declination. All distances are to a nail in side of witness objects unless otherwise noted.

FORM APPROVED BY MICHIGAN STATE BOARD OF PROFESSIONAL SURVEYORS, JAN. 28, 1971

REVISED MAY 14, 1975

REVISED JAN., 1983

REVISED OCT., 1995