

APR 07 1998

LAND CORNER RECORDATION CERTIFICATE
Filing Requirement of Act 74, Mich. P.A. 1970
Chippewa County Remonumentation Corner

SECTION

For corners in

Chippewa County	Located in:	Corner Code #
1. Public Land Survey	T45N R2W	K-8
	T R	
	T R	
	T R	
2. Property Controlling in Section	S T R	
	S T R	
3. Miscellaneous Property in Sec.	S T R	
	S T R	
4. Lot No. , Recorded Plat		
5. Private Claims		

\$7.00 LAND CORNER
\$2.00 NSSR
6 Mar 1998 2:04:47 PM Receipt #6451
RECEIVED FOR RECORD
CHIPPewa COUNTY - STATE OF MICHIGAN
SHARON H. KENNEDY, REGISTER OF DEEDS

BOOK 10 PAGE 204

Register of Deeds Stamp & File Number

I, Keith R. Waters, in a field survey on November 7, 1997, do hereby state that under requirements of P.A. 74, Michigan P.A. of 1970, the corner points mentioned in lines 1 and 2 above were in conformance with regulations and rules therefore as required in the current manual of survey instructions of the United States Department of the Interior, Bureau of Land Management or by a decree of a Court of Law and /or that the corner points mentioned in lines 3, 4 and 5 above were in conformance with the rules of the Michigan Board of Land Surveyors or by a Decree of a Court of Law; established, re-established, monumented, recovered, found as expressed below:

NOTE: Not more than 2 corners, all in the same town and range, may be recorded on this certificate.

A. Description of original monument and accessories and/or subsequent restoration:

K-8 1/4 Corner common to Sections 23 & 24, Town 45 North, Range 2 West

1849 - Original corner (spruce post) was established by Harvey Mellen, D.S.

Witnesses: White Pine 7, N25°E 40 links - Tamarack 8, N84°W 33 links

Circa 1920 - Chippewa County Surveyor Frederick H. Brown notes for Section 23 indicate that he set a post 2640 feet north of the section corner K-9.

1959 - Ray Walker, Michigan State Highway Department, liber 2, page 236, Chippewa County corner records. Corner is a 3" square wood post next to a fence post, found April 1959.

Witnesses: 6" Balsam, S70°W 48.50' - 5" Spruce, S20°W 51.25' - Fence Post, West 9.72'.

1986 - LCRC liber 6, page 361, Larry R. Rogers, P.S. 29251. Found rotted post at fence intersection and two Highway Department witnesses. Also found a concrete monument set by Harry Goodwin, N24°E 3.4 feet from post. Accepted wood post after talking with Goodwin. Replaced post with 1 1/4" iron pipe. Witnesses:

10" Spruce, S70°W 51.56' - 6" Spruce, S25°W 50.94' - 6" Spruce, S02°E 52.81' - 26" W. Pine, N76° W 108.34'

B. Description of corner evidence found and/or method applied in restoring or reestablishing corner:

This corner is being perpetuated as part of the Chippewa County Remonumentation Program.

Found a 1 1/4" iron pipe and three of the bearing trees as called for in 1986 LCRC, the 6" spruce at S02°E 52.81' is fallen down. It appears that this position is a perpetuation of the corner location as established by Brown and described in above mentioned notes. The distance to the section corner K-9 to the south is within 0.4 feet of Brown's record distance. Corner position also works well with the section corner K-7 to the north. Accepted corner as found.

C. Description of monument for corner and accessories established to perpetuate locating the position of the corner:

Found a 1 1/4" iron pipe at the corner location.

Witnesses:

10" Spruce, S70°W 51.56'

6" Spruce, S25°W 50.94'

26" White Pine, N76°W 108.34'


6" Balsam Fir, S32°W 56.94'

Note: Distances are to a nail/tag in the side of the tree.

Trees are blazed and painted.

Bearings are compass bearings corrected for declination.

	A	B	C	D	E	F	G	H	I	J	K	L	M
1													
2		6		5		4		3		2		1	
3													
4		7		8		9		10		11		12	
5													
6		18		17		16		15		14		13	
7													
8		19		20		21		22		23		24	
9													
10		30		29		28		27		26		25	
11													
12		31		32		33							
13													

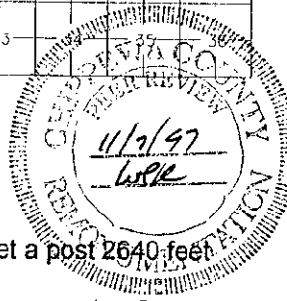

Signed by Keith R. Waters

Date 12-30-97

Surveyor's Michigan License No. 33142