KINROSS TWP
PK. 11/7/97

SURVEY &
REMONUMENTATION

APR 07 1998

LAND CORNER RECORDATION CERTIFICATE
Filing Requirement of Act 74, Mich. P.A. 1970
Chippewa County Remonumentation Corner

For corners in SECTION

Chippewa County — Located in: — Corner Code #

1. Public Land Survey — T45N R2W — K-10
   T R
   T R
   T R
2. Property Controlling — S T R
   in Section — S T R
3. Miscellaneous — S T R
   Property in Sec. — S T R

4. Lot No. , Recorded Plat
5. Private Claims

$7.00 LAND CORNER
$2.00 MSSR
6 Mar 1998 2:05:57 PM Receipt #6451
RECEIVED FOR RECORD
CHIPPEWA COUNTY - STATE OF MICHIGAN
SHARON M. KENNEDY, REGISTER OF DEEDS

BOOK 10 PAGE 206

Register of Deeds Stamp & File Number

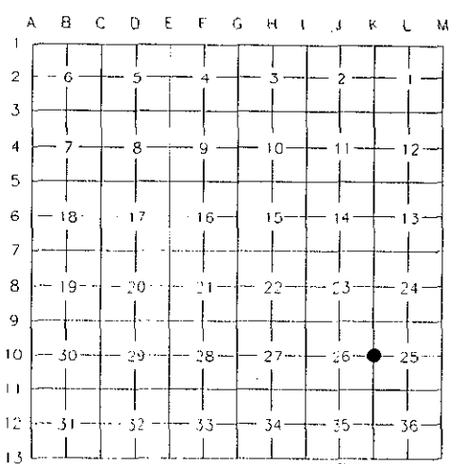

I, Keith R. Waters, in a field survey on August 19, 1997, do hereby state that under requirements of P.A. 74, Michigan P.A. of 1970, the corner points mentioned in lines 1 and 2 above were in conformance with regulations and rules therefore as required in the current manual of survey instructions of the United States Department of the Interior, Bureau of Land Management or by a decree of a Court of Law and /or that the corner points mentioned in lines 3, 4 and 5 above were in conformance with the rules of the Michigan Board of Land Surveyors or by a Decree of a Court of Law; established, re-established, monumented, recovered, found as expressed below:

NOTE: Not more than 2 corners, all in the same town and range, may be recorded on this certificate.

A. Description of original monument and accessories and/or subsequent restoration:

K-10 ¼ Corner common to Sections 25 & 26, Town 45 North, Range 2 West

1849 - Original corner (tamarack post) was established by Harvey Mellen, D.S.
Witnesses: Tamarack 8, N59°E 32 links
Tamarack 6, S80°W 38 links

1974 - LCRC liber 1, page 129, Lawrence R. Feindt, RLS 21566. Found railroad spike.
Witnesses: 12" Poplar, S20°W 95.80' - 8" White Pine, S20°E 91.10' - 11" Tamarack, N10°E 124.80'

CHIPPEWA COUNTY REMONUMENTATION PEER REVIEW 11/1/97 WTK

B. Description of corner evidence found and/or method applied in restoring or reestablishing corner:

This corner is being perpetuated as part of the Chippewa County Remonumentation Program.
Found a railroad spike 0.5 feet east of the centerline of north-south asphalt road (Kinross Lake Road) and the Poplar and White Pine bearing trees as called for in above mentioned LCRC. Railroad spike is 2626.8 feet from section corner to the north, 2615.4 from section corner south, and is 1.4 feet east of a straight line between said section corners. I have been unable to determine the origin of this position. It has been used for numerous surveys in both Sections 25 and 26 for at least 23 years, and I am accepting the position as found.

C. Description of monument for corner and accessories established to perpetuate locating the position of the corner:

Placed a ¾" x 24" rebar with a plastic Chippewa County Remonumentation cap at corner location, replacing a found railroad spike. Corner is 0.5 feet east of the centerline of Kinross Lake Road.
Witnesses:

Nail/tag #33142 in the side of 14" White Pine (blazed), S20°E 91.32'
Nail/tag #33142 in the side of 12" White Pine (blazed), S86°E 17.04'
Nail/tag #33142 in the side of 11" Tamarack, (blazed), N80°E 39.76'
Nail/tag in face blaze in 14" Aspen, S22°W 95.91'
2" i.d. Iron Pipe, S88°E 32.97'

Note: Bearings are compass bearings corrected for declination.

STATE OF MICHIGAN
KEITH R. WATERS
PROFESSIONAL SURVEYOR
No. 33142
LICENSED PROFESSIONAL SURVEYOR

Signed by Keith R. Waters Date 12-30-97

Surveyor's Michigan License No. 33142

FORM APPROVED BY MICHIGAN STATE BOARD OF PROFESSIONAL SURVEYORS, JAN. 28, 1971
REVISED MAY 14, 1975
REVISED JAN., 1983
REVISED OCT., 1995

BOOK 10 PAGE 206

LCRC T45N R2W K-10