

CHIPPEWA COUNTY REMONUMENTATION CORNER

MAR 27 1996

LAND CORNER RECORDATION CERTIFICATE

Filing Requirement of Act 74, Mich. P.A. 1970

COMMISSION

For corners in

Chippewa

(County)

Located In:

Corner Code #

1. Public Land Survey

T46N R2W

I-13 Same

T45N R2W

I-1 Corner

T R

T R

S T

S T

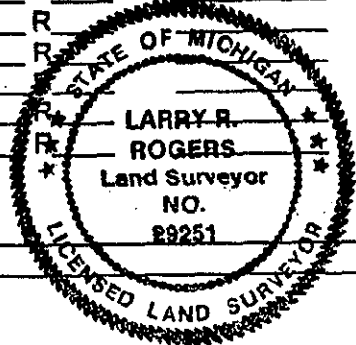

\$ 7.00 LAND CORNER
 \$ 2.00 MSSR
 29 FEB 96 9:35 A.M. RECEIPT# 462
 RECEIVED FOR RECORD
 CHIPPEWA COUNTY - STATE OF MICHIGAN
 SHARON H. KENNEDY, REGISTER OF DEEDS

Register of Deeds Stamp & File Number

4. Lot No. _____, Recorded Plat _____
 5. Private Claims _____

I, Larry R. Rogers, in a field survey on Oct. 10, 1995 do hereby state that under requirements of P.A. 74, Michigan P.A. of 1970, the corner points mentioned in lines 1 and 2 above were in conformance with regulations and rules therefore as required in the current manual of survey instructions of the United States Department of the Interior, Bureau of Land Management or by a decree of a Court of Law and/or that the corner points mentioned in lines 3, 4 and 5 above were in conformance with the rules of the Michigan Board of Land Surveyors or by a Decree of a Court of Law; established, re-established, monumented, recovered, found as expressed below:

NOTE: Not more than 2 corners, all in the same town and range, may be recorded on this certificate.

	A	B	C	D	E	F	G	H	I	J	K	L	M
1													
2	6		5		4		3		2		1		
3													
4	7		8		9		10		11		12		
5													
6	18		17		16		15		14		13		
7													
8	19		20		21		22		23		24		
9													
10	30		29		28		27		26		25		
11													
12	31		32		33		34		35		36		
13													

A. Description of original monument and accessories and/or subsequent restoration:

(I-13) South 1/4 Corner of Section 36, T46N, R2W

Nov 1840: Austin Burt "set quarter section post" with the following witnesses:
 8" Spruce N54E 19 links 10" Spruce N27W 26 links

1913: County Surveyor F. Brown set by single proportionate measurement between Southwest and Southeast corners of Section 36. Distance recorded as 2633 feet to Southwest and Southeast corners.

1980: Corner referenced in survey by H. Goodwin, P.S. 5434 but not specifically identified. Corner fell on range of fence to North and 33 feet North of 1/2" rebar.

B. Description of corner evidence found and/or method applied in restoring or reestablishing corner:


(I-13) This corner is being perpetuated as part of the Chippewa County Remonumentation Program.

Found no evidence of original corner position. Found (loose) 3/4" iron bolt with washer, 10" below grade at South edge of 12 Mile Road. Found 1/2" rebar 30.5 feet South. Did not hold 3/4" iron bolt. Re-established corner position midway and on-line between Southeast and Southwest corners of Section 36. Distances East and West are 2631.98 feet (2633 Co. Surv.). Corner falls on extension of apparent 1/4 line fence to North and 32.9 feet North to 1/2" rebar from Goodwin survey.

C. Description of monument for corner and accessories established to perpetuate locating the position of the corner:

(I-13) Corner is a 3/4"x24" iron with plastic "Chippewa County Remonumentation" cap, 6 feet South of centerline of 12 Mile Road (gravel).

Witnesses: "V" Notch North end of Culvert N55°E 33.40'
 14" Balsam Fir N82°W 322.18'
 Utility Pole (DR4/75/59) S77°W 96.23'
 "V" Notch South end of Culvert S64°E 26.96'

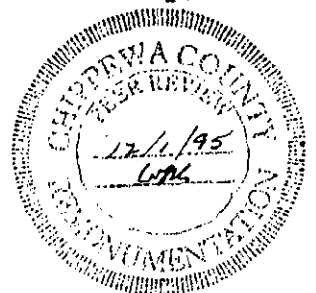

Signed by [Signature]

Date 25 DEC 1995

Surveyor's Michigan License No. 29251

NOTE: All bearings are compass bearings corrected for declination. All distances are to a nail in side of witness objects unless otherwise noted.

FORM APPROVED BY MICHIGAN STATE BOARD OF PROFESSIONAL SURVEYORS, JAN. 28, 1971

REVISED MAY 14, 1975
 REVISED JAN., 1983
 REVISED OCT., 1995