

**SURVEY &  
REMONUMENTATION**

KINKROSS LWP  
PR: 11/7/97 ✓

**APR 07 1998 LAND CORNER RECORDATION CERTIFICATE**  
Filing Requirement of Act 74, Mich. P.A. 1970  
Chippewa County Remonumentation Corner

Corners in	SECTION	Located in:	Corner Code #
Chippewa County			
1. Public Land Survey		T45N R2W	L-11
		T R	
		T R	
		T R	
2. Property Controlling in Section	S	T R	
	S	T R	
3. Miscellaneous Property in Sec.	S	T R	
	S	T R	
4. Lot No.			Recorded Plat
5. Private Claims			

\$7.00 LAND CORNER  
\$2.00 NSSR  
6 Mar 1998 2:09:01 PM Receipt #6451  
RECEIVED FOR RECORD  
CHIPPEWA COUNTY - STATE OF MICHIGAN  
SHARON H. KENNEDY, REGISTER OF DEEDS

BOOK 10 PAGE 211  
Register of Deeds Stamp & File Number

I, Keith R. Waters, in a field survey on August 19, 1997, do hereby state that under requirements of P.A. 74, Michigan P.A. of 1970, the corner points mentioned in lines 1 and 2 above were in conformance with regulations and rules therefore as required in the current manual of survey instructions of the United States Department of the Interior, Bureau of Land Management or by a decree of a Court of Law and/or that the corner points mentioned in lines 3, 4 and 5 above were in conformance with the rules of the Michigan Board of Land Surveyors or by a Decree of a Court of Law, established, re-established, monumented, recovered, found as expressed below:

NOTE: Not more than 2 corners, all in the same town and range, may be recorded on this certificate.

A. Description of original monument and accessories and/or subsequent restoration:

L-11 1/4 Corner common to Sections 25 & 36, Town 45 North, Range 2 West

1849 - Original corner (cedar post) was established by Harvey Mellen, D.S.  
Witnesses: Hemlock 10, N44°E 24 links - Hemlock 7, S82°W 9 links

1973 - LCRC liber 1, page 129, Lawrence Feindt, RLS 21566. Sketch of Section 25 on the back of this LCRC shows this corner midway on line between section corners 2646.52 feet east and west, position was not monumented

1973 - LCRC liber 1, page 77, Donald R. Verba, RLS 13603. Set 5/8" rebar w/cap at centerline of road at intersection with fence line to north. Corner is on line between NW and NE corners. Witnesses:  
8" Spruce, Az. 29° 47.33' - 40" Tri-Birch, Az. 69° 100.72 - 10" Spruce, Az. 138° 70.45' - P. Pole, Az. 303° 64.04'

B. Description of corner evidence found and/or method applied in restoring or reestablishing corner:

This corner is being perpetuated as part of the Chippewa County Remonumentation Program. Found a 5/8" rebar with cap #13603 and three of the witnesses as called for in the 1973 LCRC liber 1, page 77. Found rebar is 9.1 feet west of an equal split between section corners as shown on the LCRC in liber 1, page 129. The position of the found rebar has been used for most of the considerable amount of survey work which has been done in Sections 25 and 36, and is based on fence line evidence. Accepted the found rebar as the corner location.


C. Description of monument for corner and accessories established to perpetuate locating the position of the corner:

Found a 5/8" rebar with a plastic cap #13603 at the corner location, which falls in the centerline of Kallio Road.  
Witnesses:

- Nail/tag #13603 in 16" Spruce, S42°E 70.45'
- Nail/tag #13603 in 16" Birch, N64°E 100.66' (in clump of 3 trees)
- Nail/tag #13603 in Power Pole (E54), N59°W 64.01'
- Nail/tag #33142 in 9" Red Maple, N18°E 66.34'

Note: Bearings are compass bearings corrected for declination.  
Trees are blazed and painted.

	A	B	C	D	E	F	G	H	I	J	K	L	M
1													
2	6		5		4		3		2		1		
3													
4	7		8		9		10		11		12		
5													
6	18		17		16		15		14		13		
7													
8	19		20		21		22		23		24		
9													
10	30		29		28		27		26		25		
11													
12	31		32		33		34		35		36		
13													

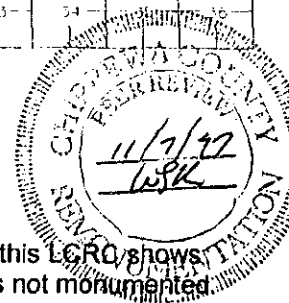

Signed by Keith R. Waters

Date 12-30-97

Surveyor's Michigan License No. 33142