

**SURVEY & REMONUMENTATION**

APR 26 1995

CHIPPEWA COUNTY REMONUMENTATION CORNER

COMMISSION

**LAND CORNER RECORDATION CERTIFICATE**

Filing Requirement of Act 74, Mich. P.A. 1970

For corners in  
Chippewa

(County)

Located In:

Corner Code #

1. Public Land Survey

T 45N R 1W A-7 Same  
T 45N R 2W M-7 Corner

\$ 7.00 LAND CORNER  
\$ 2.00 MSSR  
19 JAN 95 4:03 P.M. RECEIPT# 2266  
RECEIVED FOR RECORD  
CHIPPEWA COUNTY - STATE OF MICHIGAN  
SHARON H. KENNEDY, REGISTER OF DEEDS  
Register of Deeds Stamp & File Number

2. Property Controlling in Section


S T R  
S T R

3. Miscellaneous Property in Sec.

S T R  
S T R

4. Lot No. \_\_\_\_\_, Recorded Plat

5. Private Claims

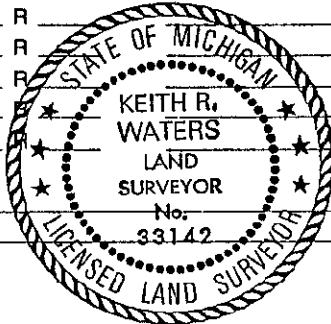

	A	B	C	D	E	F	G	H	I	J	K	L	M
2	6		5		4		3		2		1		
3													
4	7		8		9		10		11		12		
5													
6	18		17		16		15		14		13		
7													
8	19		20		21		22		23		24		
9													
10	30		29		28		27		26		25		
11													
12	31		32		33		34		35		36		
13													

I, Keith R. Waters in a field survey on November 30, 1994, do hereby certify that under requirements of P.A. 74, Michigan P.A. of 1970, the corner points mentioned in lines 1 and 2 above were in conformance with regulations and rules therefore as required in the current manual of survey instructions of the United States Department of the Interior, Bureau of Land Management or by a decree of a Court of Law and/or that the corner points mentioned in lines 3, 4 and 5 above were in conformance with the rules of the Michigan Board of Land Surveyors or by a Decree of a Court of Law: established, re-established, monumented, re-monumented, recovered, found as expressed below:

**NOTE: Not more than 4 corners, all in the same town and range, may be recorded on this certificate.**

A. Description of original monument and accessories and/or subsequent restoration:

A-7 Corner Common to Secs. 18 & 19, T45N, R1W & Secs. 13 & 24, T45N, R2W.

Original ties to post: Hemlock 16, N82°W 48 links Hemlock 16, S33°W 25 links 1959 - Highway Department, as recorded in liber 2, page 253, Chippewa County corner records. Corner is a 1½" iron.


Date unknown - Highway Department, liber 2, page 232. Corner is 1" iron pin. 1978 - Liber 1, page 368, Thomas Kelly, RLS 24599. Found 1½" iron pin and a white pine bearing tree from 1959 Highway Department records.

B. Description of corner evidence found and/or method applied in restoring or reestablishing corner:

A-7 (T45N, R1W)

This corner is being perpetuated as part of the Chippewa County Remonumentation Program.

Found a 1½" square head iron pin with round base and white pine bearing tree as shown in liber 1, page 368. Corner is on the west side of Highway I-75, and east of Mackinac Trail, north of a metal storage building. Accepted corner as found and established new witness objects.

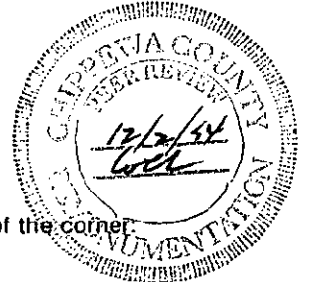

C. Description of monument for corner and accessories established to perpetuate locating the position of the corner:

A-7 (T45N, R1W)

Corner is a 1½" square head iron pin with a round base on the west side of I-75, east of Mackinac Trail, north of metal storage building. Witnesses:

- Power Pole (291), N27°E 159.96'
- 20" Spruce, N17°W 115.40'
- 24" White Pine, N53°W 97.50'
- 36" White Pine, N67°W 136.45'

Note: Distances are to a nail and tag in the side of the witness object. Trees are blazed and painted. Bearings are compass bearings corrected for declination.

Signed by Keith R. Waters

Date 12-23-94

Surveyor's Michigan License No. 33142