

SURVEY & REMONUMENTATION

APR 26 1995

COMMISSION

LAND CORNER RECORDATION CERTIFICATE
Filing Requirement of Act 74, Mich. P.A. 1970

For corners in
Chippewa
(County)

Located In:

Corner Code #

1. Public Land Survey Sec. Cor. T. 45N. R. 2W. ✓
common to T. 45N. R. 1W. ✓
T. _____ R. _____
T. _____ R. _____
2. Property Controlling S. _____ T. _____ R. _____
in Section S. _____ T. _____ R. _____
3. Miscellaneous S. _____ T. _____ R. _____
Property In Sec. S. _____ T. _____ R. _____
4. Lot No. _____, Recorded Plat _____
5. Private Claims _____

M-11
A-11

RECEIVED FOR RECORD
CHIPPEWA COUNTY
STATE OF MICHIGAN

94 FEB 28 PM 2:37

J. Roger Matlock

REGISTER OF DEEDS


Register of Deeds Stamp & File Number

I, Gary E. Koepke, in a field survey on January 25, 19 94, do hereby certify that under requirements of P.A. 74, Michigan P.A. of 1970, the corner points mentioned in lines 1 and 2 above were in conformance with regulations and rules therefore as required in the current manual of survey instructions of the United States Department of the Interior, Bureau of Land Management or by a decree of a Court of Law and/or that the corner points mentioned in lines 3, 4 and 5 above were in conformance with the rules of the Michigan Board of Land Surveyors or by a Decree of a Court of Law; established, re-established, monumented, re-monumented, recovered, found as expressed below:

	A	B	C	D	E	F	G	H	I	J	K	L	M
2	6	5	4	3	2	1							
3													
4	7	8	9	10	11	12							
5													
6	18	17	16	15	14	13							
7													
8	19	20	21	22	23	24							
9													
10	30	29	28	27	26	25							
11													
12	31	32	33	34	35	36							
13													

NOTE: Not more than 4 corners, all in the same town and range, may be recorded on this certificate.

- A. Description of original monument and accessories and/or subsequent restoration:
 From 1942 Road plans of Tone Rd.: Sec. Cor. (2 1/2" Iron Pipe) related to Tone Rd. Alignment.
 From 1973 LCRC; L.1, Pg. 76: (M-11) Fnd T-Iron. Fits ownership evidence. Cor. at extension of centerline Tone Rd. & road north. RLS Tag 40" Dbl. Oak Az. 40° 97.73'
 RLS Tag P.P. AZ. 62° 49.15' --- RLS Tag 18" Dbl. Maple Az. 355° 76.43'
 From 1974 LCRC; L.1, Pg. 129: (M-11) T-Iron Found.
 Power Pole N45°E. 49.10' --- Twin Oak 12" N35°E. 97.50' --- Power Pole N80°W. 149.80'
 From 1978 LCRC; L.1, Pg. 367: (A-11) Found T Iron called for in Recorded Surveys L.1, Pg.29.
 P.Pole (E-68) N58°E. 48.40' --- NW Cor Cyclone Fence S73°E. 216.00' --- P.Pole (E-67) N78°W. 150.00'
 From MDOT Preliminary Research Notes, 1991, RLS #27447: Found old Tone Rd. alignment P.I. and T Iron in close agreement with location for Sec. Cor. according to 1942 road plans.
- B. Description of corner evidence found and/or method applied in restoring or reestablishing corner:
 Found "T" Iron apparently undisturbed as previously recorded.
 Accepted T Iron as Sec. Cor. and witnessed.

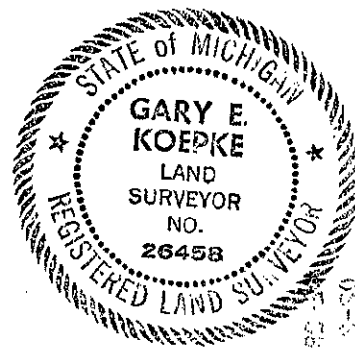

- C. Description of monument for corner and accessories established to perpetuate locating the position of the corner:
 "T" Iron, located South of Tone Rd. in line with road to North.

Witnesses: N. 80° W. 151.07' MDOT Tag in P.P. #(E67)
 N. 60° E. 48.38' MDOT Tag in P.P. #(E68)
 N. 35° E. 98.65' MDOT Tag in 16" Twin Oak; 96.97' to blaze in face.
 N. 05° W. 69.32' MDOT Tag in 8" Oak
 N. 88° 35' 06" E. 62.40' 1942 Plan Alignment P.I. (1" Pipe)

Signed by Gary E. Koepke
 Surveyor's Michigan License No. 26458

Date Jan. 31, 1994