

LAND CORNER RECORDATION CERTIFICATE

FILING REQUIREMENT OF ACT 74, MICH. P.A.1970
Chippewa Co. Two Corners.

FOR CORNERS OF--	LOCATED IN--	CORNER CODE NUMBER
1. PUBLIC LAND SURVEY _____	T. <u>45</u> N. X , R. <u>7</u> X W.	B-3
2. PROPERTY CONTROLLING IN SECTION <u>7</u>	, T. <u>45</u> N. X , R. <u>7</u> X W.	2-Sec.7
3. MISCELLANEOUS PROPERTY IN SECTION _____	, T. _____ N. _____, R. _____ E. _____ W.	_____
4. LOT NO. _____, RECORDED PLAT _____		
5. PRIVATE CLAIMS _____		

REGISTER OF DEEDS STAMP AND FILING NUMBER

I, Billy D. Buckler do hereby certify that under requirements of P.A. 74, Michigan P.A. of 1970, the corner points mentioned in lines 1 and 2 above (identified with circles on index code diagram—over) were, in a field survey on 1-23 1974, established, re-established, monumented, re-monumented, recovered or restored as expressed below and in conformance with regulations and rules therefore as required in the current manual of survey instructions of the United States Department of the Interior, Bureau of Land Management or by a decree of a court of law. Furthermore, that the corner points mentioned in lines 3, 4 and 5 above were, in a field survey on _____ 19____, found, recovered, restored, established or re-established as expressed below and in conformance with the rules of the Michigan State Board of Registration for Land Surveyors or, by a Decree of a Court of law:


A. Description of original monument and accessories and/or subsequent restoration:
 B-3 $\frac{1}{4}$ Corner bet. Sec's. 6-7, set by Wells Burt, D.S., 1850.
 Bearings were: Cedar 20", S31°W, 4 lks. and Spruce 12", N4°E, 23 lks.
 2-Sec.7 East 1/16 Corner, on North side, Section 7.

B. Description of corner evidence found and/or method applied in restoring or re-establishing corner:
 B-3 Corner re-established by single proportionate measure, between two Section Corners. No evidence of original corner.
 2-Sec.7 Corner established midway and on line, bet. Sec. Cor. to East and $\frac{1}{4}$ Cor. to West.

C. Description of monument for corner and accessories established to perpetuate locating the position of the corner:
 Placed 1" pipes and 4" aluminium caps at both corners.
 B-3 New Bearings: 13" Cedar, N10°E, 27.5' and 13" Cedar, S79°E, 18.0'
 2-Sec.7 New Bearings: 8" Cedar, N26°W, 40.1' and 6" B. Spruce, S75°E, 7.0'

SIGNED BY Billy D. Buckler DATE 2-5-74

SURVEYOR'S MICHIGAN REGISTRATION NO. 8887

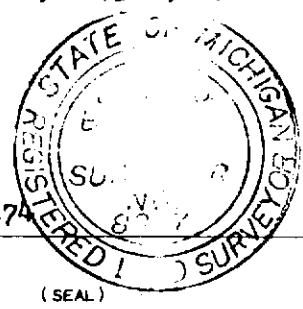

FOR STATE AND UNITED STATES AGENCIES:

SIGNED BY _____ DATE _____
CHIEF OF SURVEY PARTY

APPROVED AND SIGNED BY _____ DATE _____