

MICHIGAN  
DEPARTMENT OF CONSERVATION  
FORESTRY DIVISION

# LAND CORNER RECORD

T. 45-46N N.R. 7W

Chippewa COUNTY

DESCRIPTION OF CORNER Section corner common to sections 3-4-33-34


CORNER MONUMENT 1" pipe with 4" aluminum cap.

DATE MONUMENT PLACED AND WITNESSED 9-27-62

WITNESSES TO CORNER..... 6" Cedar (S33 NBT) N31°W, 09 links

5" Cedar (S34 NBT) N42°E, 19½ links

7" Cedar (S3 NBT) S43°E, 14½ links

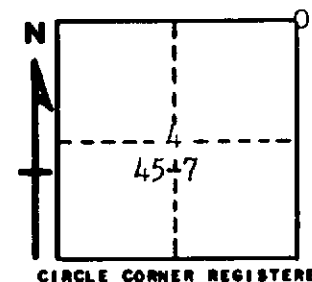

AND \_\_\_\_\_

**DESCRIPTION IN DETAIL AS TO HOW CORNER WAS LOCATED AND IDENTIFIED OR RESTORED.**

This corner replaced from one tamarack B.T. bearing S30°W, 08 links. (original notes indicate S30°E, 08 links).

Scribe marks plain and in excellent condition; tree down. Found rotted spruce stump bottom bearing N47°W, 14 links for probable B.<sup>1</sup>.

**SURVEYOR'S SEAL**

SIGNED Billy D. Buckler DATE March 7, 1963  
REGISTERED LAND SURVEYOR  
Billy D. Buckler