LAND CORNER RECORDATION CERTIFICATE
Filing Requirement of Act 74, Mich. P.A. 1970 as Amended

For corners in

Chippewa (County)

		Located In:	Corner Code #
1. Public Land Survey		T 45N R 7W	A9
		T___ R___	
		T___ R___	
	S___	T___ R___	
2. Property Controlling	S___	T___ R___	
in Section	S___	T___ R___	
3. Miscellaneous	S___	T___ R___	
Property in Sec.	S___	T___ R___	

Register of Deeds Stamp & File Number

4. Lot No. _____ , Recorded Plat_____

5. Private Claims

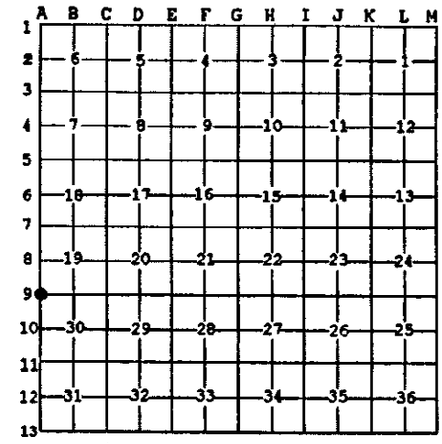

Jun 17 2003

I, Stephan J. Szyszkoski, in a field survey on _____, 20 ____ do hereby state that under requirements of P.A. 74, Michigan P.A. of 1970, the corner points mentioned in lines 1 and 2 above were in conformance with regulations and rules therefore as required in the current manual of survey instructions of the United States Department of the Interior, Bureau of Land Management or by a decree of a Court of Law and /or that the corner points mentioned in lines 3, 4 and 5 above were in conformance with the rules of the Michigan Board of Land Surveyors or by a Decree of a Court of Law; established, re-established, monumented, recovered, found as expressed below:

NOTE: Not more than 2 corners, all in the same town and range, may be recorded on this certificate.

A. Description of original monument and accessories and/or subsequent restoration:

(A9) Corner common to Sections 24-25 T45N-R08W and 19-30 T45N-R07W. 1960: The corner was reestablished by proportionate measure along the township line by Billy D. Buckler. Set 1" pipe with 4" brass cap. 11" Hard Maple S83W 44.5 links, 13" Hard Maple S41E 18.5 links, 8" Hard Maple N74E 12 links (ref. LCRC 859A, Luce County Records).

B. Description of corner evidence found and/or method applied in restoring or reestablishing corner:

(A9) Recovered the 1960 monument projecting 1.7' above ground, in good condition, and at record bearing and distance from the remaining two 1960 witnesses SW and SE, both in good condition. Left the monument in place and made new accessories as described below.

C. Description of monument for corner and accessories established to perpetuate locating the position of the corner:

(A9) Found 1" ID I. pipe with 4" brass
MI Dept of Conservation cap. Blazed,
scribed and set measuring nails in:
7" Maple N06E 17.1' "S24 NBT"
13" Maple N52E 32.0' "S19 NBT"
The 1960 wits:
16" Maple S35E 12.85'
15" Maple S85W 29.8'
Bearings are magnetic. Distances are to
nail with tag.

STATE OF MICHIGAN
STEPHAN J. SZYSZKOSKI
LAND SURVEYOR
No. 33986
LICENSED LAND SURVEYOR

Signed by Stephan J. Szyszkoski Date 10/16/03

Surveyor's Michigan License No. 33986

For the Michigan Department of Natural Resources, Office of Land and Facilities

FORM APPROVED BY MICHIGAN STATE BOARD OF PROFESSIONAL SURVEYORS, JAN. 28, 1971
Revised May 14, 1975
Revised Jan., 1983
Revised Oct., 1995