

JAN 16 1999

LAND CORNER RECORDATION CERTIFICATE
Filing Requirement of Act 74, Mich. P.A. 1970
Chippewa County Remonumentation Corner

SECTION

For corners in

Chippewa County

Located In: Corner Code #

- 1. Public Land Survey T 46N R 2E K-13 SAME
T 45N R 2E K-1 CORNER
2. Property Controlling in Section S T R
3. Miscellaneous Property in Sec. S T R

\$7.00 LAND CORNER
\$2.00 NSSR
21 JAN 1999 11:07:52 AM Receipt #13123
RECEIVED FOR RECORD
CHIPPEWA COUNTY - STATE OF MICHIGAN
SHARON H. KENNEDY, REGISTER OF DEEDS

BOOK 10 PAGE 373

Register of Deeds Stamp & File Number

- 4. Lot No. Recorded Plat
5. Private Claims

I, William L. Karr in a field survey on October 2, 1998, do hereby state that under requirements of P.A. 74, Michigan P.A. of 1970, the corner points mentioned in lines 1 and 2 above were in conformance with regulations and rules therefore as required in the current manual of survey instructions of the United States Department of the Interior, Bureau of Land Management or by a decree of a Court of Law and/or that the corner points mentioned in lines 3, 4 and 5 above were in conformance with the rules of the Michigan Board of Land Surveyors or by a Decree of a Court of Law; established, re-established, monumented, recovered, found as expressed below:

NOTE: Not more than 2 corners, all in the same town and range, may be recorded on this certificate.

Grid table with columns A-M and rows 1-13. Contains handwritten 'T46N R2E' and a dot in cell 12M.


- A. Description of original monument and accessories and/or subsequent restoration:
(K-13) Corner Common to Sections 35 and 36, Township 46 North, Range 2 East and Sections 1 and 2, Township 45 North, Range 2 East.
1845: J. Mullett, P.S. set post. Aspen 12 N41'E 50 Birch 10 N38'W 37
1895: F.H. Brown County Surveyor recovered (1) original BT and established (3) new witnesses: W. Pine 14, N13'E 78.5 feet, W. Pine 12, (1920) N39'W 83 feet, Center of Big Stone 62.5 feet.
1977: J.H. Granger, P.S. 16041 found a 1" bolt and recovered all (3) 1920 witnesses and recorded corner in Liber 1, Page 266 of the Chippewa County Corner Records.

- B. Description of corner evidence found and/or method applied in restoring or reestablishing corner:
(K-13) Corner Common to Sections 35 and 36, Township 46 North, Range 2 East and Sections 1 and 2, Township 45 North, Range 2 East.
This corner is being perpetuated as part of the Chippewa County Remonumentation Program.
Found a 1" bolt and all witnesses as noted on 1977 corner certificate. Both W. Pines from 1920 are still standing

- C. Description of monument for corner and accessories established to perpetuate locating the position of the corner:
(K-13) Corner Common to Sections 35 and 36, Township 46 North, Range 2 East and Sections 1 and 2, Township 45 North, Range 2 East.
Corner is a 1" bolt.

Witnesses:

Table with 3 columns: Witness, Bearing, Distance. Includes W. Pine 27", W. Pine 29", Bolt in Large Rock, Maple 14", Spruce 12" with bearings and distances.

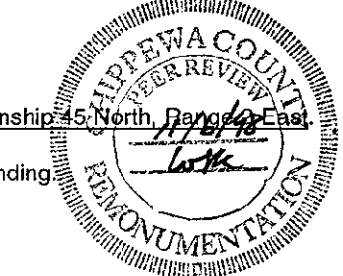

Signed by [Signature] Date 12/22/98

Surveyor's Michigan License No. 27450
NOTE: All bearings are compass bearings corrected for declination. All distances are to a nail and tag in the side of witness object unless otherwise noted.