

CHIPPewa COUNTY REGISTER OF DEEDS

JAN 19 1999

LAND CORNER RECORDATION CERTIFICATE
Filing Requirement of Act 74, Mich. P.A. 1970
Chippewa County Remonumentation Corner

For corners in SECTION

Chippewa County Located In: Corner Code #
1. Public Land Survey T 46N R 2E L-13 SAME
T 45N R 2E L-1 CORNER
2. Property Controlling in Section S T R
3. Miscellaneous Property in Sec. S T R
4. Lot No. Recorded Plat
5. Private Claims

\$7.00 LAND CORNER
\$2.00 NSSR
21 JAN 1999 11:07:14 AM Receipt #13123
RECEIVED FOR RECORD
CHIPPewa COUNTY -- STATE OF MICHIGAN
SHARON H. KENNEDY, REGISTER OF DEEDS


BOOK 10 PAGE 372
Register of Deeds Stamp & File Number

I, William L. Karr in a field survey on October 2, 1998, do hereby state that under requirements of P.A. 74, Michigan P.A. of 1970, the corner points mentioned in lines 1 and 2 above were in conformance with regulations and rules therefore as required in the current manual of survey instructions of the United States Department of the Interior, Bureau of Land Management or by a decree of a Court of Law and/or that the corner points mentioned in lines 3, 4 and 5 above were in conformance with the rules of the Michigan Board of Land Surveyors or by a Decree of a Court of Law; established, re-established, monumented, recovered, found as expressed below:

NOTE: Not more than 2 corners, all in the same town and range, may be recorded on this certificate.

Grid table with columns A-M and rows 1-13. Contains handwritten 'T 46N R 2E' and a dot in the bottom right corner.

A. Description of original monument and accessories and/or subsequent restoration:
(L-13) 1/4 Corner Common to Section 36, Township 46 North, Range 2 East and Section 1, Township 45 North, Range 2 East.
1845: J. Mullett set post for corner. Sugar 10 N20°E 32
Sugar 10 N32°W 24
1895: F.H. Brown County Surveyor measured South Line of Southwest 1/4 of Section 36, as 2588 feet and South line of Government Lot (1920) 4, Section 36 as 697 feet (Total of 3285 feet).
1977: J.H. Granger, P.S. 16041 re-established the corner using proportionate measurement between the meander corner to the East and the Section corner to the West. Corner was recorded in Liber 1, Page 260 of the Chippewa County Records.

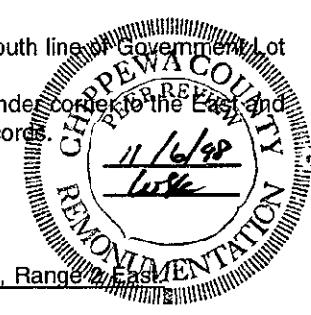

B. Description of corner evidence found and/or method applied in restoring or reestablishing corner:
(L-13) 1/4 Corner Common to Section 36, Township 46 North, Range 2 East and Section 1, Township 45 North, Range 2 East.
This corner is being perpetuated as part of the Chippewa County Remonumentation Program.
Found a 1/2" iron with cap number 16041 and all witnesses as previously recorded. New measurement (1998) from Section Corner 35, 36, 1 and 2 East to Meander Corner 36/1 is 3283.68 feet; this should yield proportionate measurements of 2586.96 feet to the West and 696.72 feet to the East. Existing measurements are 2585.52 feet and 698.16 feet respectively. It appears that the 1/4 Corner was mis-placed by approximately 1.44 feet to the West. A substantial amount of survey work has been based on this position. I accepted the corner position re-established in 1977.

C. Description of monument for corner and accessories established to perpetuate locating the position of the corner:
(L-13) 1/4 Corner Common to Section 36, Township 46 North, Range 2 East and Section 1, Township 45 North, Range 2 East.
Corner is a 1/2" iron with cap number 16041.

Witnesses:
Maple 14" N85°W 27.97 feet
Maple 10" N30°W 11.75 feet
Maple 13" N65°E 40.52 feet
M.C. 36/1 East 698.16 feet



Signed by William L. Karr Date 12/22/98

Surveyor's Michigan License No. 27450

NOTE: All bearings are compass bearings corrected for declination. All distances are to a nail and tag in the side of witness object unless otherwise noted.