

SURVEY & REMONUMENTATION **LAND CORNER RECORDATION CERTIFICATE**
Filing Requirement of Act 74, Mich. P.A. 1970
Chippewa County Remonumentation Corner

For corners in **APR 07 1998**

Chippewa County Located in: Corner Code #

SECTION

1. Public Land Survey T45N R2W A-6 Same ✓
 T45N R3W M-6 Corner ✓
 T R
 T R
 T R

2. Property Controlling S T R
 in Section S T R

3. Miscellaneous S T R
 Property in Sec. S T R

4. Lot No. , Recorded Plat

5. Private Claims

\$7.00 LAND CORNER
 \$2.00 MSSR
 6 Mar 1998 1:22:14 PM Receipt #6451
 RECEIVED FOR RECORD
 CHIPPEWA COUNTY - STATE OF MICHIGAN
 SHARON H. KENNEDY, REGISTER OF DEEDS

BOOK **10** PAGE **157**

Register of Deeds Stamp & File Number

I, Keith R. Waters, in a field survey on July 10, 1997, do hereby state that under requirements of P.A. 74, Michigan P.A. of 1970, the corner points mentioned in lines 1 and 2 above were in conformance with regulations and rules therefore as required in the current manual of survey instructions of the United States Department of the Interior, Bureau of Land Management or by a decree of a Court of Law and /or that the corner points mentioned in lines 3, 4 and 5 above were in conformance with the rules of the Michigan Board of Land Surveyors or by a Decree of a Court of Law; established, re-established, monumented, recovered, found as expressed below:

NOTE: Not more than 2 corners, all in the same town and range, may be recorded on this certificate.

A. Description of original monument and accessories and/or subsequent restoration:

A-6 1/4 Corner common to Sec. 18, T45N, R2W & Sec. 13, T45N, R3W

1840 - Original corner was established by Austin Burt, D.S.
 Witnesses: Sugar 18, S76°W 53 links - Sugar 18, N55°W 22 links.

1982 - LCRC liber 5, page 223, William L. Karr, P.S. 27450. Found a 4"x4" wood post with a 12" spike set next to post. Replaced spike with a 1/2" iron. Witnesses: Centerline of north-south road, East 15.5' - 12" Maple, N37°E 61.61' - 8" Maple, S45°E 58.74' - 8" Maple, S13°W 36.46' - 12" Maple, N71°W 11.72'

B. Description of corner evidence found and/or method applied in restoring or reestablishing corner:



This corner is being perpetuated as part of the Chippewa County Remonumentation Program. Found a 1/2" iron and all four bearing trees as called for in above mentioned LCRC. This position checks very well with other corners south on the range line in both north-south and east-west directions. Accepted corner position as found.

C. Description of monument for corner and accessories established to perpetuate locating the position of the corner:

Found a 1/2" rebar at corner position, next to a rotted 4"x4" post, 15 feet west of a north-south dirt road.
 Witnesses:

12" Maple, N37°E 61.61'
 8" Maple, S45°E 58.74'
 8" Maple, S13°W 36.46'
 12" Maple, N71°W 11.72'

Note: Distances are to a nail in the side of the tree.
 Bearings are compass bearings corrected for declination.

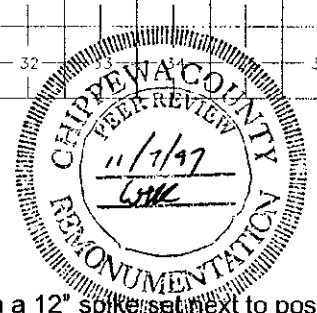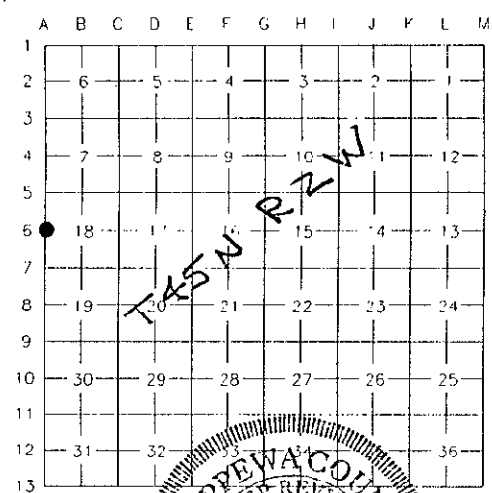

Signed by Keith R. Waters

Date 12-30-97

Surveyor's Michigan License No. 33142