

CHIPPEWA COUNTY REMONUMENTATION CORNER

LAND CORNER RECORDATION CERTIFICATE

Filing Requirement of Act 74, Mich. P.A. 1970 \$ 7.00 LAND CORNER

For corners in

Chippewa  
(County)

Located in:

Corner Code #

1. Public Land Survey

T46N R 2W

(A-2) Same

T46N R 3W

M-2/ Corner

T R

T R

2. Property Controlling in Section

S

T R

S

T R

3. Miscellaneous Property in Sec.

S

T R

S

T R

\$ 2.00 NSSR

29 FEB 96 9:26 A.M.

RECEIPT# 462

RECEIVED FOR RECORD

CHIPPEWA COUNTY - STATE OF MICHIGAN

SHARON H. KENNEDY, REGISTER OF DEEDS

Register of Deeds Stamp & File Number

4. Lot No. \_\_\_\_\_, Recorded Plat \_\_\_\_\_

MAR 27 1996

5. Private Claims \_\_\_\_\_

COMMISSION

I, William L. Karr, in a field survey on Dec. 13, 1995 do hereby state that under requirements of P.A. 74, Michigan P.A. of 1970, the corner points mentioned in lines 1 and 2 above were in conformance with regulations and rules therefore as required in the current manual of survey instructions of the United States Department of the Interior, Bureau of Land Management or by a decree of a Court of Law and for that the corner points mentioned in lines 3, 4 and 5 above were in conformance with the rules of the Michigan Board of Land Surveyors or by a Decree of a Court of Law; established, re-established, monumented, recovered, found as expressed below:

	A	B	C	D	E	F	G	H	I	J	K	L	M
1													
2	6		5		4		3		2		1		
3													
4	7		8		9		10		11		12		
5													
6	18		17		16		15		14		13		
7													
8	19		20		21		22		23		24		
9													
10	30		29		28		27		26		25		
11													
12	31		32		33		34		35		36		
13													

NOTE: Not more than 2 corners, all in the same town and range, may be recorded on this certificate.

A. Description of original monument and accessories and/or subsequent restoration:

(A-2) 1/4 Corner Section 6, T46N, R2W and Section 1, T46N, R3W (M-3)

1840: Austin Burt set post in 1840

Hemlock 20" S29°W 37 links Birch 10" N54°W 10 links

1941: Corner was established as part of a G.L.O. dependent resurvey. Set 6" diameter concrete monument with brass cap.

15" Y. Birch N38°E 51 links 12" Y. Birch N32°W 21 links

1978: H. Stockholm, P.S. 23519 recorded corner for the U.S.F.S. in Liber 4, Page 72. Recovered brass capped monument and established new witness.

B. Description of corner evidence found and/or method applied in restoring or reestablishing corner:



(A-2) This corner is being perpetuated as part of the Chippewa County Remonumentation program.

Found 6" diameter concrete monument with brass cap and post in undisturbed condition also found all (3) witnesses from 1978. Both yellow Birch's were still in place but in poor condition. Accepted corner position as found.

C. Description of monument for corner and accessories established to perpetuate locating the position of the corner:

(A-2) Corner is a brass cap set in concrete 12" above ground. Post 5" is North 30° East with signs.

Witnesses: 7" Maple N04°W 33.56'  
6" Maple N78°E 57.64'  
8" Maple S62°E 26.56' (existing)  
3" Cedar N68°W 20.28'

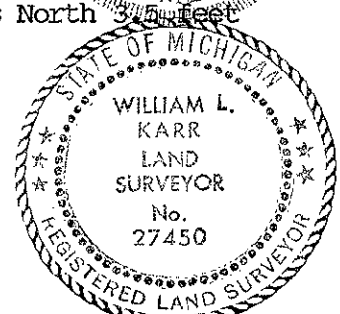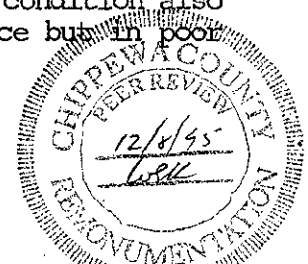

Signed by William L. Karr  
Surveyor's Michigan License No. 27450

Date 12/13/95

NOTE: Bearings are compass bearings corrected for declination. Distances are to a nail in side of witness objects unless noted.