

MAR 27 1996

CHIPPEWA COUNTY REMONUMENTATION CORNER

LAND CORNER RECORDATION CERTIFICATE
Filing Requirement of Act 74, Mich. P.A. 1970

For corners in COMMISSION

<u>Chippewa</u> (County)	Located In:	Corner Code #
1. Public Land Survey	T46N R 2W T46N R 3W T ___ R ___ T ___ R ___	(A-4) Same M-4/ Corner _____ _____
2. Property Controlling in Section	S ___ T ___ R ___ S ___ T ___ R ___	_____ _____
3. Miscellaneous Property in Sec.	S ___ T ___ R ___ S ___ T ___ R ___	_____ _____

\$ 7.00 LAND CORNER
\$ 2.00 NSSR
29 FEB 96 9:27 A.M. RECEIPT# 462
RECEIVED FOR RECORD
CHIPPEWA COUNTY - STATE OF MICHIGAN
SHARON H. KENNEDY, REGISTER OF DEEDS

Register of Deeds Stamp & File Number

4. Lot No. _____, Recorded Plat _____
5. Private Claims _____

I, William L. Karr, in a field survey on Dec. 13, 1995 do hereby state that under requirements of P.A. 74, Michigan P.A. of 1970, the corner points mentioned in lines 1 and 2 above were in conformance with regulations and rules therefore as required in the current manual of survey instructions of the United States Department of the Interior, Bureau of Land Management or by a decree of a Court of Law and/or that the corner points mentioned in lines 3, 4 and 5 above were in conformance with the rules of the Michigan Board of Land Surveyors or by a Decree of a Court of Law; established, re-established, monumented, recovered, found as expressed below.

NOTE: Not more than 2 corners, all in the same town and range, may be recorded on this certificate.

A	B	C	D	E	F	G	H	I	J	K	L	M
1												
2	6		5		4		3		2		1	
3												
4	7		8		9		10		11		12	
5												
6	18		17		16		15		14		13	
7												
8	19		20		21		22		23		24	
9												
10	30		29		28		27		26		25	
11												
12	31		32		33		34		35		36	
13												

A. Description of original monument and accessories and/or subsequent restoration:

(A-4) 1/4 Corner Section 7, T46N, R2W and Section 12, T46N, R3W (M-4)

1840: Austin Burt set post

Fir 10" S20°W 19 links Sugar 7" N71°W 42 links


1941: G.L.O. established corner and set a 6" diameter concrete monument with brass cap.

1977: J.H. Granger found G.L.O. brass capped monument recorded corner in Liber 1, Page 252 of corner records.

B. Description of corner evidence found and/or method applied in restoring or reestablishing corner:

(A-4) This corner is being perpetuated as part of the Chippewa County Remonumentation program.

Found G.L.O. brass capped monument in Irish Line Road as described by J.H.G. in Liber 1, Page 252. Accepted corner position as found.

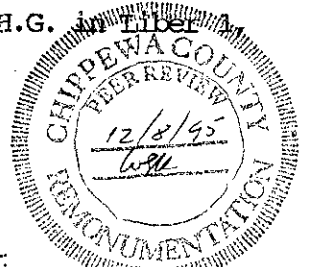

C. Description of monument for corner and accessories established to perpetuate locating the position of the corner:

(A-4) Corner is G.L.O. brass capped monument 4.2 feet West of centerline Irish Line Road on extension of 2-Trail to West.

Witnesses:	8" Elm	N04°W	92.75'
	11" White Birch	S10°W	111.57'
	8" Elm	N11°E	120.25'
	Power Pole	S65°E	51.79'



Signed by William L. Karr
Surveyor's Michigan License No. 27450

Date 12/13/95

NOTE: Bearings are compass bearings corrected for declination. Distances are to a nail in side of witness objects unless noted. FORM APPROVED BY MICHIGAN STATE BOARD OF PROFESSIONAL SURVEYORS, JAN. 28, 1971
REVISED MAY 14, 1975
REVISED JAN., 1983
REVISED OCT., 1996