

APR 07 1998

LAND CORNER RECORDATION CERTIFICATE  
Filing Requirement of Act 74, Mich. P.A. 1970  
Chippewa County Remonumentation Corner

SECTION

\$7.00 LAND CORNER  
\$2.00 MSSR  
12 Mar 1998 12:37:59 PM Receipt #6527  
RECEIVED FOR RECORD  
CHIPPewa COUNTY - STATE OF MICHIGAN  
SHARON H. KENNEDY, REGISTER OF DEEDS  
BOOK 10 PAGE 215

Register of Deeds Stamp & File Number

For corners in

Chippewa

Located In:

Corner Code #

1. Public Land Survey

T 46N R 2W

A-11 Same  
M-11 Corner

T 46N R 3W

T R

T R

2. Property Controlling  
In Section

S T R

S T R

3. Miscellaneous  
Property in Sec.

S T R

S T R

4. Lot No. \_\_\_\_\_, Recorded Plat \_\_\_\_\_

5. Private Claims \_\_\_\_\_

William L. Karr, in a field survey on November 3, 1997, do hereby state that under requirements of P.A. 74, Michigan P.A. of 1970, the corner points mentioned in lines 1 and 2 above were in conformance with regulations and rules therefore as required in the current manual of survey instructions of the United States Department of the Interior, Bureau of Land Management or by a decree of a Court of Law and/or that the corner points mentioned in lines 3, 4 and 5 above were in conformance with the rules of the Michigan Board of Land Surveyors or by a Decree of a Court of Law; established, re-established, monumented, recovered, found as expressed below:

NOTE: Not more than 2 corners, all in the same town and range, may be recorded on this certificate.


	A	B	C	D	E	F	G	H	I	J	K	L	M
1													
2	6		5		4		3		2		1		
3													
4	7		8		9		10		11		12		
5													
6	18		17		16		15		14		13		
7													
8	19		20		21		22		23		24		
9													
10	30		29		28		27		26		25		
11													
12	31		32		33		34		35		36		
13													

Description of original monument and accessories and/or subsequent restoration:

(A-11) Section Corner Common to Sections 30 and 31, T.46 N., R.2 W., and Sections 25 and 36, T.46 N., R.3 W.

1849 Austin Burt, D.S. set post in original survey. Witnesses: Fir 14 S55°W 25  
Birch 12 N24°W 8

County Surveyor Corner Tie Book, Page 116) lists ties for this corner. They appear to be for another corner. 1995 Ron Bischer, P.S. 22428, found a 1" bar and established (4) witnesses.

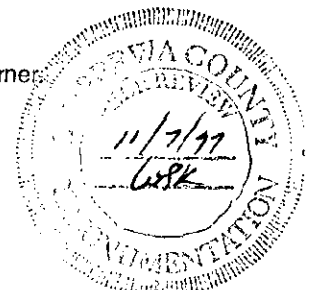

Description of corner evidence found and/or method applied in restoring or reestablishing corner:

(A-11) Section Corner Common to Sections 30 and 31, T.46 N., R.2 W., and Sections 25 and 36, T.46 N., R.3 W.

This corner is being perpetuated as part of the Chippewa County Remonumentation Program.


Found no evidence of the original corner. Found the 1" bar and all (4) witnesses established by Ron Bischer. Distance North is 2640.4' to 1/4 corner 25/30; distance South is 5268.8' to the Township corner 31, 6, 1 and 36. Accepted corner position as found.

Description of monument for corner and accessories established to perpetuate locating the position of the corner:

(A-11) Section Corner Common to Sections 30 and 31, T.46 N., R.2 W., and Sections 25 and 36, T.46 N., R.3 W.

Corner is a 1" x 1 1/4" head bolt at grade, 6' East of the centerline of a North-South Two Track Trail.

Witnesses: W. Birch 24" N82°E 31.30' (existing tag)  
Aspen 8" S40°E 25.95' (existing tag)  
Aspen 6" S23°W 47.17' (existing tag)  
Aspen 14" N77°W 13.73' (existing tag)

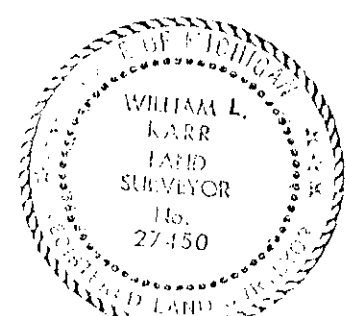

Set by William L. Karr

Date 12/25/97

Surveyor's Michigan License No. 27450

All bearings are compass bearings corrected for declination (6°W). All distances are to a nail and tag in the side of witness object unless otherwise noted.