

SURVEY &
REMONUMENTATION

1993

COMMISSION

Chippewa County Remonumentation Corner

LAND CORNER RECORDATION CERTIFICATE

Filing Requirement of Act 74, Mich. P.A. 1970

For corners in

Chippewa

(County)

Located In:

Corner Code #

- | | | |
|---------------------------------------|-------------------------|-----------------|
| 1. Public Land Survey | T 46N R 2W | <u>B-1</u> Same |
| | T 47N R 2W | B-13 Corner |
| | T _____ R _____ | _____ |
| | T _____ R _____ | _____ |
| 2. Property Controlling in Section | S _____ T _____ R _____ | _____ |
| | S _____ T _____ R _____ | _____ |
| 3. Miscellaneous Property in Sec. | S _____ T _____ R _____ | _____ |
| | S _____ T _____ R _____ | _____ |
| 4. Lot No. _____, Recorded Plat _____ | | |
| 5. Private Claims _____ | | |

RECEIVED FOR RECORD
CHIPPEWA COUNTY
STATE OF MICHIGAN

93 NOV 31 AM 10:09

J. Roger Malotte

REGISTER OF DEEDS

Register of Deeds Stamp & File Number

I, William L. Karr, in a field survey on May 25, 19 93, do hereby certify that under requirements of P.A. 74, Michigan P.A. of 1970, the corner points mentioned in lines 1 and 2 above were in conformance with regulations and rules therefore as required in the current manual of survey instructions of the United States Department of the Interior, Bureau of Land Management or by a decree of a Court of Law and/or that the corner points mentioned in lines 3, 4 and 5 above were in conformance with the rules of the Michigan Board of Land Surveyors or by a Decree of a Court of Law; established, re-established, monumented, re-monumented, recovered, found as expressed below:

NOTE: Not more than 4 corners, all in the same town and range, may be recorded on this certificate.

A. Description of original monument and accessories and/or subsequent restoration:

(B-1) 1/4 Corner Sections 31 & 6

1840 William A. Burt, set post
16" Cedar N09°E 27 links
10" B. Ash N44°W 30 links

1975 Stephen G. Kopach, Cadastral Surveyor B.L.M. Dependent Re-Survey
Set iron post with brass cap, 0.49 chains West of Iroquois Road.
Telephone Pole (BR1/64) N50°E 136 links


B. Description of corner evidence found and/or method applied in restoring or reestablishing corner:

(B-1) This corner is being perpetuated as part of the Chippewa County Remonumentation Program.

Found the BLM Monument and the "Telephone" pole called for.
Accepted position as found.
Added nail to side of power pole and three additional witnesses.

C. Description of monument for corner and accessories established to perpetuate locating the position of the corner:
(B-1) Corner is a 2 1/2" pipe with brass cap stamped: 1/4 S. 31/6 and falls 3' West of centerline of ditch and 32.7' West of centerline of Lakeshore Drive.

Witnesses: 10" Ash	N25°W	55.50'
Power Pole (BR1/64)	N51°E	89.52'
"V" in East end aluminum culvert	N74°E	67.20'
6" Triple Ash	S40°E	126.95'

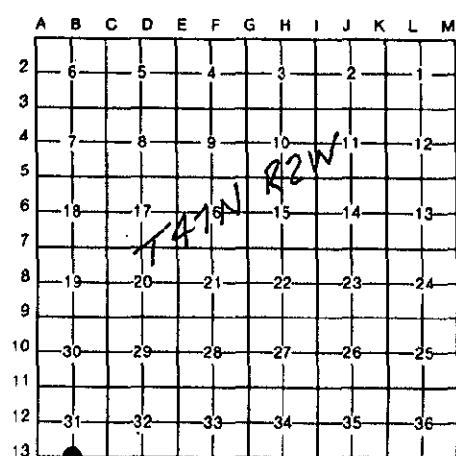

Signed by *William L. Karr* Date 11/12/93

Surveyor's Michigan License No. 27450

NOTE: Bearings are compass bearings corrected for declination.
Distances are to a nail in side of witness objects unless noted.