

**SURVEY & REMONUMENTATION**

MAY 28 1997

COMMISSION

CHIPPEWA COUNTY REMONUMENTATION CORNER

**LAND CORNER RECORDATION CERTIFICATE**  
Filing Requirement of Act 74, Mich. P.A. 1970

For corners in

|                                    |                            |               |
|------------------------------------|----------------------------|---------------|
| <u>Chippewa</u><br>(County)        | Located In:                | Corner Code # |
| 1. Public Land Survey              | T <u>46</u> N R <u>2</u> W | B-3           |
|                                    | T ___ R ___                | _____         |
|                                    | T ___ R ___                | _____         |
|                                    | T ___ R ___                | _____         |
| 2. Property Controlling in Section | S ___ T ___ R ___          | _____         |
|                                    | S ___ T ___ R ___          | _____         |
| 3. Miscellaneous Property in Sec.  | S ___ T ___ R ___          | _____         |
|                                    | S ___ T ___ R ___          | _____         |

\$7.00 LAND CORNER

\$2.00 MSSR  
3/4/1997 1:58:15 PM Receipt #294  
RECEIVED FOR RECORD  
CHIPPEWA COUNTY - STATE OF MICHIGAN  
SHARON H. KENNEDY, REGISTER OF DEEDS


BOOK 10 PAGE 56

Register of Deeds Stamp & File Number

4. Lot No. \_\_\_\_\_, Recorded Plat \_\_\_\_\_  
5. Private Claims \_\_\_\_\_

I, William L. Karr, in a field survey on Dec. 3, 1996 do hereby state that under requirements of P.A. 74, Michigan P.A. of 1970, the corner points mentioned in lines 1 and 2 above were in conformance with regulations and rules therefore as required in the current manual of survey instructions of the United States Department of the Interior, Bureau of Land Management or by a decree of a Court of Law and /or that the corner points mentioned in lines 3, 4 and 5 above were in conformance with the rules of the Michigan Board of Land Surveyors or by a Decree of a Court of Law; established, re-established, monumented, recovered, found as expressed below:

NOTE: Not more than 2 corners, all in the same town and range, may be recorded on this certificate.

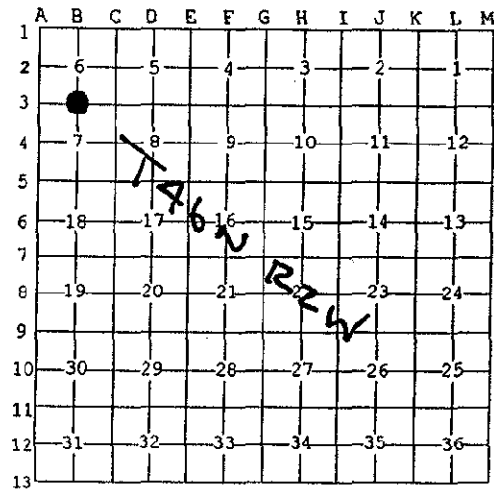

A. Description of original monument and accessories and/or subsequent restoration:

(B-3) 1/4 Corner Common to Sections 6 & 7, T.46 N., R.2 W.

1849: H. Mellen set post Y. Birch 10 S25°W 13  
Hemlock 20 N70°E 25

1975: Dependent re-survey by U.S. Department of Interior established corner by proportionate distance.

1980: J.H. Granger, P.S. 16041 accepted corner as found. Corner recorded in Liber 4, Page 377 of the Chippewa County Corner Records.

B. Description of corner evidence found and/or method applied in restoring or reestablishing corner:

(B-3) This Corner is being perpetuated as part of the Chippewa County Remonumentation Program.


Found no evidence of original corner. Found U.S. Department of Interior (B.L.M.) corner as recorded by Granger. Accepted corner as found and added witnesses.



C. Description of monument for corner and accessories established to perpetuate locating the position of the corner:

(B-3) Corner is a 2-1/2" iron pipe with B.L.M. brass cap marked T.46 N., R.2 W.

|            |              |       |        |
|------------|--------------|-------|--------|
| Witnesses: | 6" Maple     | N60°E | 17.20' |
|            | 4" Maple     | S50°E | 3.18'  |
|            | 12" Spruce   | S78°W | 13.50' |
|            | 12" Y. Birch | N54°W | 25.60' |

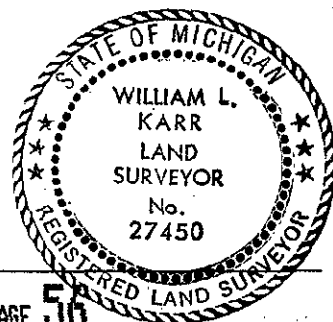

Signed by William L. Karr  
Surveyor's Michigan License No. 27450

Date 12-30-96

BOOK 10 PAGE 56

NOTE: All bearings are compass bearings corrected for declination. All distances are to a nail in side of witness objects unless noted.