

**SURVEY &
REMONUMENTATION**

MAY 28 1997

CHIPPEWA COUNTY REMONUMENTATION CORNER

COMMISSION

LAND CORNER RECORDATION CERTIFICATE
Filing Requirement of Act 74, Mich. P.A. 1970

For corners in

| | | |
|---------------------------------------|-------------|---------------|
| <u>Chippewa</u> (County) | Located In: | Corner Code # |
| 1. Public Land Survey | T46N R 2W | B-5 |
| | T R | |
| | T R | |
| | T R | |
| 2. Property Controlling in Section | S T R | |
| | S T R | |
| 3. Miscellaneous Property in Sec. | S T R | |
| | S T R | |

\$2.00 MSSR
3/4/1997 2:00:02 PM Receipt #294
RECEIVED FOR RECORD
CHIPPEWA COUNTY - STATE OF MICHIGAN
SHARON H. KENNEDY, REGISTER OF DEEDS



BOOK 10 PAGE 57

Register of Deeds Stamp & File Number

4. Lot No. _____, Recorded Plat _____
5. Private Claims _____

I, William L. Karr, in a field survey on Dec. 4, 1996 do hereby state that under requirements of P.A. 74, Michigan P.A. of 1970, the corner points mentioned in lines 1 and 2 above were in conformance with regulations and rules therefore as required in the current manual of survey instructions of the United States Department of the Interior, Bureau of Land Management or by a decree of a Court of Law and for that the corner points mentioned in lines 3, 4 and 5 above were in conformance with the rules of the Michigan Board of Land Surveyors or by a Decree of a Court of Law; established, re-established, monumented, recovered, found as expressed below:

NOTE: Not more than 2 corners, all in the same town and range, may be recorded on this certificate.

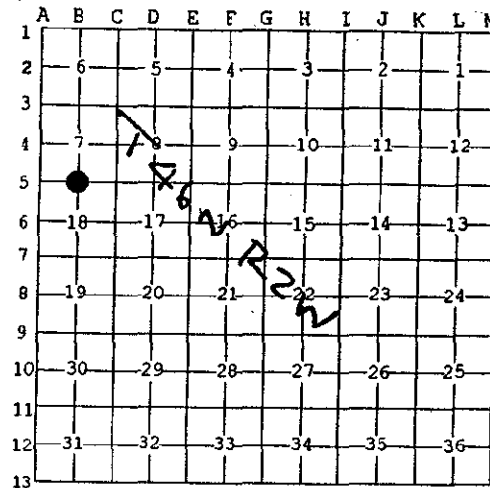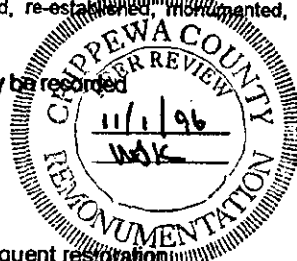

A. Description of original monument and accessories and/or subsequent restoration:
(B-5) 1/4 Corner Common to Sections 7 & 18, T.46 N., R.2 W.

1849: H. Mellen set post Y. Birch 10 S50°W 27
Hemlock 10 N56°E 28

1980: J.H. Granger, P.S. 16041 re-established corner by single proportionate measurement using original government distance between Southeast and Southwest Section corners. Corner was recorded in Liber 1, Page 251. Corner re-recorded in Liber 4, Page 375 of the Chippewa County Corner Records.

B. Description of corner evidence found and/or method applied in restoring or reestablishing corner:

(B-5) This Corner is being perpetuated as part of the Chippewa County Remonumentation Program.

Found corner as recorded by Granger in 1980. Accepted corner as found and added witnesses.

C. Description of monument for corner and accessories established to perpetuate locating the position of the corner:

(B-5) Corner is a 1/2" iron (flush) in a 4" concrete monument. Corner falls 3.5' East of a North-South fence line and 17' North of an East-West fence line.

| | | | | |
|------------|-------------------|-------|---------|------------|
| Witnesses: | 10" Maple (clump) | S60°E | 98.09' | (existing) |
| | 10" Poplar | S22°E | 100.41' | (existing) |
| | Corner fence post | S19°W | 16.80' | |
| | 8" Elm | S42°W | 154.76' | (existing) |



Signed by William L. Karr
Surveyor's Michigan License No. 27450

Date 12-30-96

NOTE: All bearings are compass bearings corrected for declination. All distances are to a nail in side of witness objects unless noted.