

CHIPPEWA COUNTY REMONUMENTATION CORNER

MAR 27 1996

LAND CORNER RECORDATION CERTIFICATE
Filing Requirement of Act 74, Mich. P.A. 1970

For corners in COMMISSION

<u>Chippewa</u> (County)	Located In:	Corner Code #
1. Public Land Survey	T46N R2W	B-7
	T R	
	T R	
	T R	
2. Property Controlling in Section	S T R	
	S T R	
3. Miscellaneous Property in Sec.	S T R	
	S T R	


\$ 7.00 LAND CORNER
\$ 2.00 MSSR
29 FEB 96 9:28 A.M. RECEIPT# 462
RECEIVED FOR RECORD
CHIPPEWA COUNTY - STATE OF MICHIGAN
SHARON H. KENNEDY, REGISTER OF DEEDS

Register of Deeds Stamp & File Number

4. Lot No. _____, Recorded Plat _____
5. Private Claims _____

I, Larry R. Rogers, in a field survey on Dec. 19, 1995 do hereby state that under requirements of P.A. 74, Michigan P.A. of 1970, the corner points mentioned in lines 1 and 2 above were in conformance with regulations and rules therefore as required in the current manual of survey instructions of the United States Department of the Interior, Bureau of Land Management or by a decree of a Court of Law and/or that the corner points mentioned in lines 3, 4 and 5 above were in conformance with the rules of the Michigan Board of Land Surveyors or by a Decree of a Court of Law; established, re-established, monumented, recovered, found as expressed below:

NOTE: Not more than 2 corners, all in the same town and range, may be recorded on this certificate.

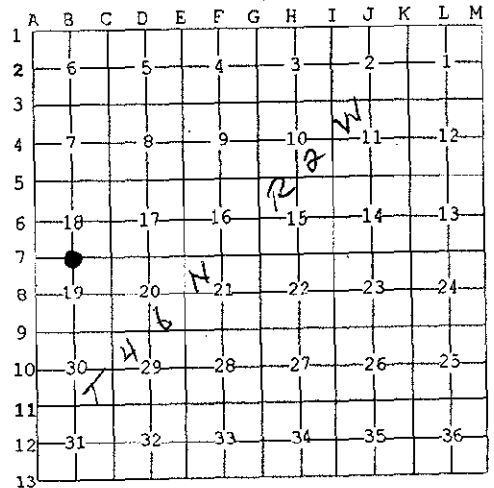

A. Description of original monument and accessories and/or subsequent restoration:
(B-7) South 1/4 Corner of Section 18, T46N, R2W


1849: Harvey Mellen "set Cedar post Cr. Section Corner" with the following witnesses:
7" Maple N75E 22 links 9" Cedar S42W 25 links

B. Description of corner evidence found and/or method applied in restoring or reestablishing corner:
(B-7) This corner is being perpetuated as part of the Chippewa County Remonumentation program.


C. Description of monument for corner and accessories established to perpetuate locating the position of the corner:
(B-7) Corner is a 3/4"x24" iron with plastic "Chippewa County Remonumentation" cap 30.8 feet South of the centerline of State Highway M-28 and on the extension of the apparent 1/4 line fence to the South.

Witnesses:	Pk Nail in centerline of M-28	N36°W	40.06'
	Pk Nail in centerline of M-28	N44°E	37.83'
	12" Spruce	S68°E	156.53'
	7" Spruce	S08°W	38.89'

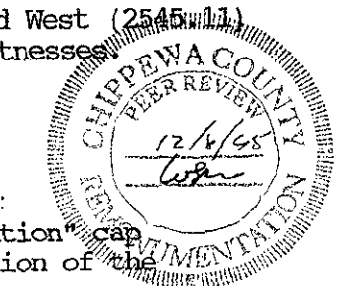

Signed by [Signature]
Surveyor's Michigan License No. 29251

Date 30 Dec 1995

NOTE: Bearings are compass bearings corrected for declination. Distances are to a nail in side of witness objects unless noted.