

X

**SURVEY &
REMONUMENTATION**

LAND CORNER RECORDATION CERTIFICATE
Filing Requirement of Act 74, Mich. P.A. 1970
Chippewa County Remonumentation Corner

APR 07 1998

For corners in

<u>Chippewa</u>	Located In:	Corner Code #
1. Public Land Survey	T <u>46N</u> R <u>2W</u>	<u>B-9</u>
	T ___ R ___	
	T ___ R ___	
	T ___ R ___	
2. Property Controlling in Section	S ___ T ___ R ___	
	S ___ T ___ R ___	
3. Miscellaneous Property in Sec.	S ___ T ___ R ___	
	S ___ T ___ R ___	


\$7.00 LAND CORNER
\$2.00 NGSS
SECTION
12 Mar 1998 12:39:26 PM Receipt #6527
RECEIVED FOR RECORD
CHIPPEWA COUNTY - STATE OF MICHIGAN
SHARON H. KENNEDY, REGISTER OF DEEDS
BOOK 10 PAGE 218

Register of Deeds Stamp & File Number

4. Lot No. _____, Recorded Plat _____
5. Private Claims _____

I, William L. Karr, in a field survey on November 11, 1997, do hereby state that under requirements of P.A. 74, Michigan P.A. of 1970, the corner points mentioned in lines 1 and 2 above were in conformance with regulations and rules therefore as required in the current manual of survey instructions of the United States Department of the Interior, Bureau of Land Management or by a decree of a Court of Law and/or that the corner points mentioned in lines 3, 4 and 5 above were in conformance with the rules of the Michigan Board of Land Surveyors or by a Decree of a Court of Law; established, re-established, monumented, recovered, found as expressed below:

NOTE: Not more than 2 corners, all in the same town and range, may be recorded on this certificate.

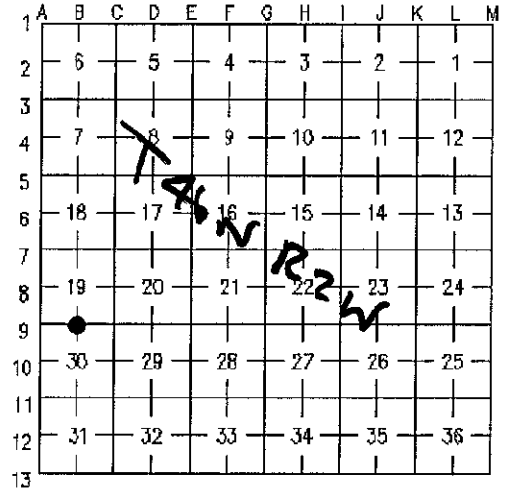

A. Description of original monument and accessories and/or subsequent restoration:

(B-9) 1/4 Corner Common to Sections 19 and 30, T.46 N., R.2 W.

1849 Harvey Mellen Spruce for 1/4 Section Corner in original survey.

Witnesses: Spruce 12 N15°W 34
Spruce 8 S46°E 24

1900 F.H. Brown shows South line of Section 19 as 5182' (computed). Also notes East 1/2 mile as 2622' and West 1/2 mile as 2547' (total of 5169').

B. Description of corner evidence found and/or method applied in restoring or reestablishing corner:

(B-9) 1/4 Corner Common to Sections 19 and 30, T.46 N., R.2 W.

This corner is being perpetuated as part of the Chippewa County Remonumentation Program.

Found no evidence of the original corner or subsequent restoration. Reestablished corner on line between the adjacent Section Corners and on the extension of the fence line to the North. Distance East is 2622.00' (C.S. measured 2622'); Distance West is 2559.00' (C.S. measured 2557').

C. Description of monument for corner and accessories established to perpetuate locating the position of the corner:

(B-9) 1/4 Corner Common to Sections 19 and 30, T.46 N., R.2 W.

Corner is a 3/4" x 24" iron with stamped aluminum Chippewa County Remonumentation Corner cap and falls on the extension of a fence line to the North and 15.11' South of a fence line to the West.

Witnesses:	Aspen 6"	S22°E	6.38'
	Aspen 6"	S41°W	63.37'
	1/2" iron	N85°W	65.03'
	Fence post	N71°W	40.18'
	Corner fence post	N02°W	11.10'

Signed by William L. Karr

Date 12/24/97

Surveyor's Michigan License No. 27450

NOTE: All bearings are compass bearings corrected for declination (6°W). All distances are to a nail and tag in the side of witness object unless otherwise noted.

FORM APPROVED BY MICHIGAN STATE BOARD OF PROFESSIONAL SURVEYORS, JAN. 28, 1971
REVISED MAY 14, 1975
REVISED JAN., 1983
REVISED OCT., 1995

