

**SURVEY &
REMONUMENTATION**

MAY 28 1997

CHIPPEWA COUNTY REMONUMENTATION CORNER

COMMISSION

LAND CORNER RECORDATION CERTIFICATE
Filing Requirement of Act 74, Mich. P.A. 1970

\$9.00 LAND CORNER

\$2.00 HSSR

3/4/1997 2:02:01 PM Receipt #294
RECEIVED FOR RECORD
CHIPPEWA COUNTY - STATE OF MICHIGAN
SHARON H. KENNEDY, REGISTER OF DEEDS

BOOK 10 PAGE 59

Register of Deeds Stamp & File Number



For corners in

<u>Chippewa</u> (County)	Located In:	Corner Code #
1. Public Land Survey	T <u>46N</u> R. <u>2W</u>	C-2
	T _____ R _____	_____
	T _____ R _____	_____
	T _____ R _____	_____
2. Property Controlling in Section	S _____ T _____ R _____	_____
	S _____ T _____ R _____	_____
3. Miscellaneous Property in Sec.	S _____ T _____ R _____	_____
	S _____ T _____ R _____	_____

4. Lot No. _____, Recorded Plat _____
5. Private Claims _____

I, William L. Karr, in a field survey on Dec. 16, 1996 do hereby state that under requirements of P.A. 74, Michigan P.A. of 1970, the corner points mentioned in lines 1 and 2 above were in conformance with regulations and rules therefore as required in the current manual of survey instructions of the United States Department of the Interior, Bureau of Land Management or by a decree of a Court of Law and for that the corner points mentioned in lines 3, 4 and 5 above were in conformance with the rules of the Michigan Board of Land Surveyors or by a Decree of a Court of Law, established, re-established, monumented, recovered, found as expressed below:

NOTE: Not more than 2 corners, all in the same town and range, may be recorded on this certificate.

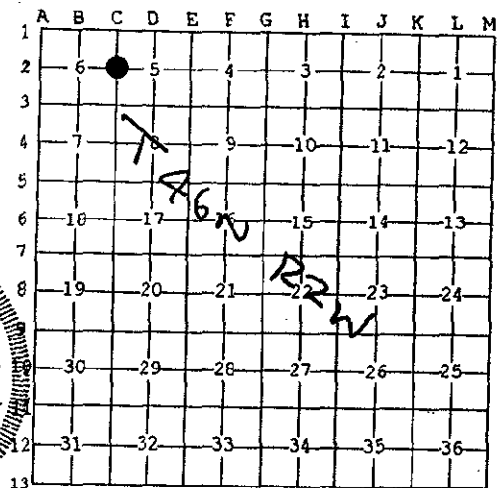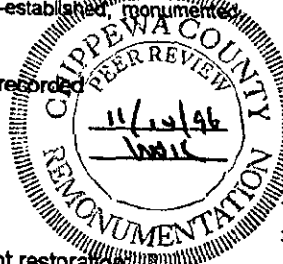

- A. Description of original monument and accessories and/or subsequent restoration:
(C-2) 1/4 Corner Common to Sections 5 & 6, T.46 N., R.2 W.
1849: H. Mellen set post Cedar 10 S30°W 20 Cedar 10 N10°E 28
1954: George D. Henning, P.S. 2240 shows this corner as being 5268.3' West of East 1/4 corner Section 5. He found both U.S. B.T.'s along with a concrete monument with iron bar.
1959: R.H. Larsen records McCready Subdivision (L.7 of Plats, Pg.26). The Southwest corner of Lot 1 is a 4" dia. concrete monument 10' East of 1/4 corner 5 & 6.
1974: N.C. Jones, P.S. 2934 records a 1/2" iron in 4" x 4" concrete post, Liber 1, Page (OVER)

- B. Description of corner evidence found and/or method applied in restoring or reestablishing corner:
(C-2) This Corner is being perpetuated as part of the Chippewa County Remonumentation Program.
 Found no evidence of original corner. Found Henning's iron bar in broken concrete. B.T.'s were gone. 4" dia. concrete monument (Southwest corner Lot 1, McCready Subdivision) is 10.00' to the East. This is the corner recorded by Jones and not the Henning corner. There are (3) remaining M.D.S.H. witnesses with tags. Also found a 2-1/2" dia. iron pipe with brass cap set by the Dept. of Interior. Accepted The Henning corner as correct. Distance 1 mile to the East checked well with 1954 survey.

- C. Description of monument for corner and accessories established to perpetuate locating the position of the corner:
(C-2) Corner is a 1" iron in broken concrete.

Witnesses:	1/2" iron in concrete (Southwest corner Lot 1)	East	10.00'
	2-1/4" iron pipe with Dept. of Interior brass cap	S22°W	2.17'
	10" Cedar	S88°W	32.95'
	8" Cedar	N57°W	32.23'



Signed by William L. Karr
 Surveyor's Michigan License No. 27450

Date 12-30-96

NOTE: All bearings are compass bearings corrected for declination. All distances are to a nail in side of witness objects unless noted.

RECONSTRUCTION &
REMONUMENTATION

MAY 28 1997
PART OF SECTION A

1974 continues: COMMISSION

112 of the Chippewa County Corner Records.

1975: Department of the Interior in a Dependent Resurvey finds no evidence of the corner and re-establishes corner by single proportionate measurement.

BOOK 10 PAGE 60