

SURVEY & REMONUMENTATION

CHIPPEWA COUNTY REMONUMENTATION CORNER

MAY 28 1997

LAND CORNER RECORDATION CERTIFICATE
Filing Requirement of Act 74, Mich. P.A. 1970 \$7.00 LAND CORNER

For corners in COMMISSION

Chippewa Located In: Corner Code #
(County)

1. Public Land Survey T46N R 2W C-3
T R
T R
T R
T R

2. Property Controlling in Section S T R
S T R

3. Miscellaneous Property in Sec. S T R
S T R

\$2.00 NSSR
3/4/1997 2:03:12 PM Receipt #294
RECEIVED FOR RECORD
CHIPPEWA COUNTY - STATE OF MICHIGAN
SHARON H. KENNEDY, REGISTER OF DEEDS



BOOK 10 PAGE 61

Register of Deeds Stamp & File Number

4. Lot No. _____, Recorded Plat _____
5. Private Claims _____

I, William L. Karr, in a field survey on Dec. 4, 1996 do hereby state that under requirements of P.A. 74, Michigan P.A. of 1970, the corner points mentioned in lines 1 and 2 above were in conformance with regulations and rules therefore as required in the current manual of survey instructions of the United States Department of the Interior, Bureau of Land Management or by a decree of a Court of Law and/or that the corner points mentioned in lines 3, 4 and 5 above were in conformance with the rules of the Michigan Board of Land Surveyors or by a Decree of a Court of Law, established, re-established, monumented, recovered, found as expressed below:

NOTE: Not more than 2 corners, all in the same town and range, may be recorded on this certificate.

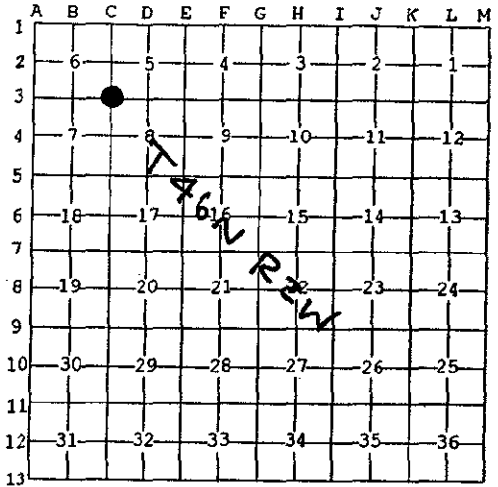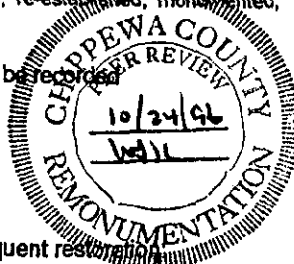

A. Description of original monument and accessories and/or subsequent restorations:
(C-3) Section Corner Common to Sections 5, 6, 7 & 8, T.46 N., R.2 W.
1849: H. Mellen set post Maple 14 S28°E 30
Maple 12 N12°W 37
1905+: County Surveyor's notes show corner ties.
1975: Dependent resurvey by U.S. Department of Interior established corner (1/2" rebar) at intersection of gravel roads.
1980: J.H. Granger, P.S. 16041 accepted corner as found. Corner was recorded in Liber 4, Page 377 of the Chippewa County Corner Records.

B. Description of corner evidence found and/or method applied in restoring or reestablishing corner:
(C-3) This Corner is being perpetuated as part of the Chippewa County Remonumentation Program.

Found no evidence of original corner. Replaced 1/2" iron (disturbed) as recorded by Granger in 1980 with 3/4" x 24" iron with plastic Chippewa County Remonumentation cap and established (2) new witnesses.

C. Description of monument for corner and accessories established to perpetuate locating the position of the corner:
(C-3) Corner is a 3/4" x 24" iron with plastic Chippewa County Remonumentation cap at intersection of paved roads to the East and South and gravel road to the West

Witnesses: Southwest garage corner N17°E 31.51' (existing)
Cedar fence post S42°E 63.05'
Power pole S15°W 219.80'
Power pole (#BRL/45) N73°W 135.71' (existing)
Power pole (#BRL/45A) N05°W 68.73'



Signed by William L. Karr
Surveyor's Michigan License No. 27450

Date 12-30-96

NOTE: All bearings are compass bearings corrected for declination. All distances are to a nail in side of witness objects unless noted.