

APR 07 1998

LAND CORNER RECORDATION CERTIFICATE
Filing Requirement of Act 74, Mich. P.A. 1970
Chippewa County Remonumentation Corner

SECTION

For corners in

Chippewa Located In: Corner Code #
1. Public Land Survey T 46N R 2W C-8
2. Property Controlling in Section S T R
3. Miscellaneous Property in Sec. S T R


\$7.00 LAND CORNER
\$2.00 NSSR
12 Mar 1998 12:40:52 PM Receipt #6527
RECEIVED FOR RECORD
CHIPPewa COUNTY - STATE OF MICHIGAN
SHARON H. KENNEDY, REGISTER OF DEEDS
BOOK 10 PAGE 221

Register of Deeds Stamp & File Number

4. Lot No. Recorded Plat
5. Private Claims

I, William L. Karr, in a field survey on November 7, 1997, do hereby state that under requirements of P.A. 74, Michigan P.A. of 1970, the corner points mentioned in lines 1 and 2 above were in conformance with regulations and rules therefore as required in the current manual of survey instructions of the United States Department of the Interior, Bureau of Land Management or by a decree of a Court of Law and/or that the corner points mentioned in lines 3, 4 and 5 above were in conformance with the rules of the Michigan Board of Land Surveyors or by a Decree of a Court of Law; established, re-established, monumented, recovered, found as expressed below:


NOTE: Not more than 2 corners, all in the same town and range, may be recorded on this certificate.

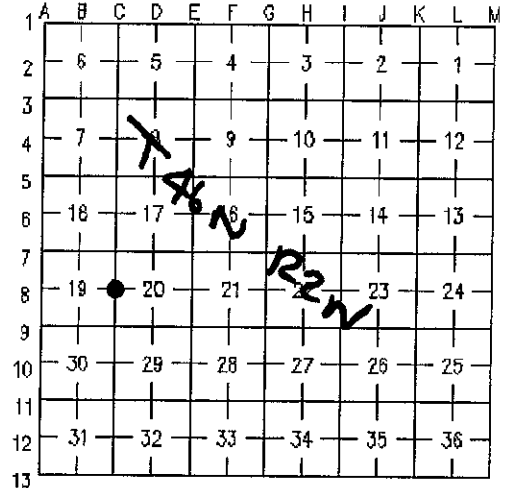

A. Description of original monument and accessories and/or subsequent restoration:

(C-8) 1/4 Corner Common to Sections 19 and 20, T.46 N., R.2 W.
1849 Harvey Mellen set Maple post in original survey. Witnesses: W. Pine 16 N19°E 27
Y. Birch 12 S30°W 34

1916 F.H. Brown, County Surveyor, ran the West line of Section 20 for a survey in Section 20. He shows the West line as 5280', and split evenly but does not indicate that he ran the line South past the 1/4 corner.

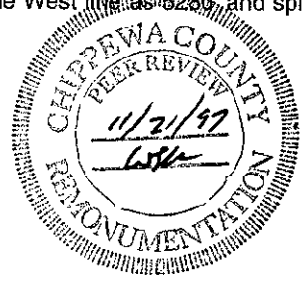

B. Description of corner evidence found and/or method applied in restoring or reestablishing corner:

(C-8) 1/4 Corner Common to Sections 19 and 20, T.46 N., R.2 W.
This corner is being perpetuated as part of the Chippewa County Remonumentation Program.

Found no evidence of original corner or subsequent restoration. Reestablished corner on line between the Section corners to the North and the South, and on the range of a fence line to the West. This position works well with the GLO stream tie 0.55 chains to the South. Distance South is 2652.96'. Distance North is 2633.72'.

C. Description of monument for corner and accessories established to perpetuate locating the position of the corner:

(C-8) 1/4 Corner Common to Sections 19 and 20, T.46 N., R.2 W.
Corner is a 3/4" x 24" iron with plastic Chippewa County Remonumentation Corner cap, 1'± West of centerline of Tilson road and 30'± North of large East-West culvert.

Witnesses: Aspen 6" N55°E 98.96'
Cedar 12" East 109.85'
Double Willow 14" S47°W 34.19'
Willow 8" N56°W 47.38'
'V' Notch in East End 48" CMP S30°E 41.05'
'V' Notch in West End 48" CMP S24°W 42.40'



Signed by William L. Karr

Date 12/29/97

Surveyor's Michigan License No. 27450

NOTE: All bearings are compass bearings corrected for declination (6°W). All distances are to a nail and tag in the side of witness object unless otherwise noted.