

MAY 28 1997

LAND CORNER RECORDATION CERTIFICATE
Filing Requirement of Act 74, Mich. P.A. 1970
 Chippewa County Remonumentation Corner

COMMISSION

For corners in

\$7.00 LAND CORNER


\$2.00 MSSR

3/4/1997 2:09:07 PM Receipt #294
 RECEIVED FOR RECORD
 CHIPPEWA COUNTY - STATE OF MICHIGAN
 SHARON H. KENNEDY, REGISTER OF DEEDS

BOOK 10 PAGE 65

Register of Deeds Stamp & File Number

Chippewa County	Located in:	Corner Code #
1. Public Land Survey	T46N R2W	C-9
	T R	
	T R	
	T R	
2. Property Controlling in Section	S T R	
	S T R	
3. Miscellaneous Property in Sec.	S T R	
	S T R	
4. Lot No. , Recorded Plat		
5. Private Claims		

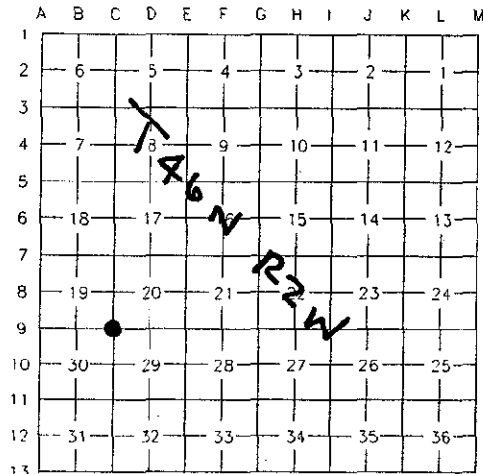

I, William L. Karr, in a field survey on December 16, 1996, do hereby state that under requirements of P.A. 74, Michigan P.A. of 1970, the corner points mentioned in lines 1 and 2 above were in conformance with regulations and rules therefore as required in the current manual of survey instructions of the United States Department of the Interior, Bureau of Land Management or by a decree of a Court of Law and /or that the corner points mentioned in lines 3, 4 and 5 above were in conformance with the rules of the Michigan Board of Land Surveyors or by a Decree of a Court of Law; established, re-established, monumented, recovered, found as expressed below:

NOTE: Not more than 2 corners, all in the same town and range, may be recorded on this certificate.

A. Description of original monument and accessories and/or subsequent restoration:

(C-9) Section Corner Common to Sections 19, 20, 29 & 30, T. 46 N., R. 2 W.

1849 H. Mellen set birch post in original survey.
 Witnesses: Spruce 7 N 76° E 25 lks
 Cedar 9 S 05° W 13 lks

1916 F.H. Brown, County Surveyor, surveyed portions of section 20. West line of 20 was noted at 5280'. No dimension was given for South line.

B. Description of corner evidence found and/or method applied in restoring or reestablishing corner:

(C-9) Section Corner Common to Sections 19, 20, 29 & 30, T. 46 N., R. 2 W.

This corner is being perpetuated as part of the Chippewa County Remonumentation Program.

Found 1" square iron in the centerline of North-South road and on the range of a fence line to the West. Distance North to section corner 17, 18, 19 & 20 is 5286.68'; Distance East to section corner 20, 21, 28 & 29 is 5307.18'. No other information was found on this corner.
 Accepted corner as found.


C. Description of monument for corner and accessories established to perpetuate locating the position of the corner:

(C-9) Section Corner Common to Sections 19, 20, 29 & 30, T. 46 N., R. 2 W.

Corner is a 1" square iron in the centerline of Tilson road and on the range of a fence to the West.

Witnesses: 12" Maple in Clump N 62° E 46.95'
 4" White Birch S 12° E 90.53'
 NE Corner of 'I' Beam Gate Post S 35° W 48.44'
 Center of Buried Cable Box N 54° W 28.34'

Bearings are compass bearings, corrected for declination, all distances are to a nail and tag in the side of the witness surveyors otherwise noted.

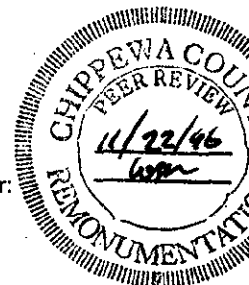

Signed by William L. Karr

Date 12-30-96

Surveyor's Michigan License No. 27450