

APR 07 1998

LAND CORNER RECORDATION CERTIFICATE
Filing Requirement of Act 74, Mich. P.A. 1970
Chippewa County Remonumentation Corner

SECTION

For corners in

Chippewa Located In: Corner Code #
1. Public Land Survey T 46N R 2W C-10
2. Property Controlling in Section S T R
3. Miscellaneous Property in Sec. S T R

\$7.00 LAND CORNER
\$2.00 MSSR
12 Mar 1998 12:41:24 PM Receipt #6527
RECEIVED FOR RECORD
CHIPPEWA COUNTY - STATE OF MICHIGAN
SHARON H. KENNEDY, REGISTER OF DEEDS
BOOK 10 PAGE 222

Register of Deeds Stamp & File Number

4. Lot No. Recorded Plat
5. Private Claims

I, William L. Karr, in a field survey on November 7, 1997, do hereby state that under requirements of P.A. 74, Michigan P.A. of 1970, the corner points mentioned in lines 1 and 2 above were in conformance with regulations and rules therefore as required in the current manual of survey instructions of the United States Department of the Interior, Bureau of Land Management or by a decree of a Court of Law and/or that the corner points mentioned in lines 3, 4 and 5 above were in conformance with the rules of the Michigan Board of Land Surveyors or by a Decree of a Court of Law; established, re-established, monumented, recovered, found as expressed below:

NOTE: Not more than 2 corners, all in the same town and range, may be recorded on this certificate.

Grid table with columns A-M and rows 1-13. Includes handwritten annotations 'T46N' and 'R2W' and a dot in section 29.

A. Description of original monument and accessories and/or subsequent restoration:

(C-10) 1/4 Corner Common to Sections 29 and 30, T.46 N., R.2 W.
1849 Harvey Mellen set Birch post in original survey. Witnesses:

Sugar 12 N85°E 19
Spruce 14 N36°W 17

Found no record or subsequent restoration.



B. Description of corner evidence found and/or method applied in restoring or reestablishing corner:


(C-10) 1/4 Corner Common to Sections 29 and 30, T.46 N., R.2 W.
This corner is being perpetuated as part of the Chippewa County Remonumentation Program.

Found no evidence of the original corner or subsequent restoration. Reestablished corner by single proportionate measurement (mid-way and on-line) between Section corner 19, 20, 29 and 30 and Section corner 29, 30, 31 and 32. Distance to the North and South is 2637.25'.

C. Description of monument for corner and accessories established to perpetuate locating the position of the corner:

(C-10) 1/4 Corner Common to Sections 29 and 30, T.46 N., R.2 W.
Corner is a 3/4" x 24" iron with Chippewa County Remonumentation Corner cap 8" below grade. Corner falls 2' East of the centerline of Tilson road.

Witnesses: Triple Burr Oak 6" N45°E 78.04'
W. Birch 4" S39°E 85.04'
Aspen 8" S52°W 75.36'
Steel gate post (N'ly) N61°W 63.31'

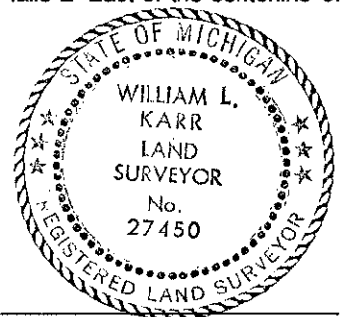

Signed by William L. Karr

Date 12/21/97

Surveyor's Michigan License No. 27450

NOTE: All bearings are compass bearings corrected for declination (6°W). All distances are to a nail and tag in the side of witness object unless otherwise noted.