

APR 07 1998

LAND CORNER RECORDATION CERTIFICATE
Filing Requirement of Act 74, Mich. P.A. 1970
Chippewa County Remonumentation Corner

SECTION

For corners in


<u>Chippewa</u>	Located In:	Corner Code #
1. Public Land Survey	T <u>46N</u> R <u>2W</u>	<u>C-11</u>
	T ___ R ___	
	T ___ R ___	
	T ___ R ___	
2. Property Controlling in Section	S ___ T ___ R ___	
	S ___ T ___ R ___	
3. Miscellaneous Property in Sec.	S ___ T ___ R ___	
	S ___ T ___ R ___	

\$7.00 LAND CORNER
\$2.00 MSSR
12 Mar 1998 12:41:49 PM Receipt #6527
RECEIVED FOR RECORD
CHIPPEWA COUNTY - STATE OF MICHIGAN
SHARON H. KENNEDY, REGISTER OF DEEDS
BOOK 10 PAGE 223
Register of Deeds Stamp & File Number

4. Lot No. _____, Recorded Plat _____
5. Private Claims _____

I, William L. Karr, in a field survey on November 4, 1997, do hereby state that under requirements of P.A. 74, Michigan P.A. of 1970, the corner points mentioned in lines 1 and 2 above were in conformance with regulations and rules therefore as required in the current manual of survey instructions of the United States Department of the Interior, Bureau of Land Management or by a decree of a Court of Law and/or that the corner points mentioned in lines 3, 4 and 5 above were in conformance with the rules of the Michigan Board of Land Surveyors or by a Decree of a Court of Law; established, re-established, monumented, recovered, found as expressed below:

NOTE: Not more than 2 corners, all in the same town and range, may be recorded on this certificate.

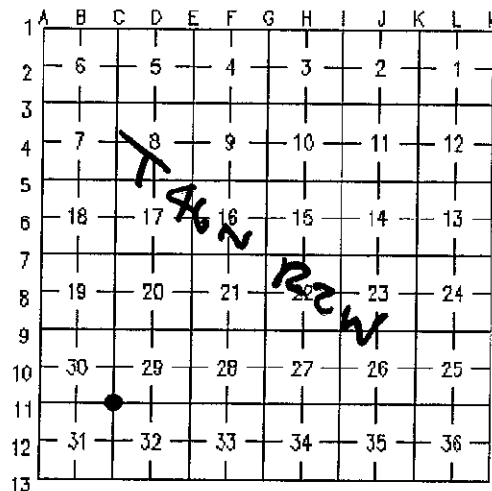


A. Description of original monument and accessories and/or subsequent restoration:

(C-11) Section Corner Common to Sections 29, 30, 31 and 32, T.46 N., R.2 W.

1849 Harvey Mellen set Spruce post in original survey. Witnesses: Tamarack 10 N40°E 21
Tamarack 7 S45°W 19

1991 Gerald Wiggins, P.S. 23521, found a 1/2" iron and replaced it with a 1" pipe and established (4) witnesses. Corner was recorded in Liber 7, Page 239 of Corner Records.

1995 Ron Bischer, P.S. 22428, found a 1 1/2" pipe and all (4) witnesses established by Wiggins.

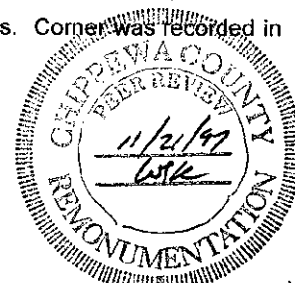

B. Description of corner evidence found and/or method applied in restoring or reestablishing corner:

(C-11) Section Corner Common to Sections 29, 30, 31 and 32, T.46 N., R.2 W.

This corner is being perpetuated as part of the Chippewa County Remonumentation Program.

Found no evidence of the original corner. Found a 1" I.D. galvanized pipe and (4) witnesses as established by Wiggins; (1) witness was dead. Top of pipe had been destroyed by a grader. Accepted corner as found and reset a 3/4" x 24" iron at pipe location and established (1) new witness.

C. Description of monument for corner and accessories established to perpetuate locating the position of the corner:

(C-11) Section Corner Common to Sections 29, 30, 31 and 32, T.46 N., R.2 W.

Corner is a 3/4" x 24" iron with plastic Chippewa County Remonumentation Corner cap, 3'± East of centerline of Tilson road.

Witnesses:	Aspen 8"	N63°E	35.11' (existing)
	Cedar post	East	22.00' (existing)
	Aspen 4"	S66°E	31.07'
	Aspen 7" (dead)		
	Spruce 18"	S67°W	48.69' (existing)
	Twin W. Birch 12"	N54°W	67.03' (existing)



Signed by William L. Karr Date 12/29/97

Surveyor's Michigan License No. 27450

NOTE: All bearings are compass bearings corrected for declination (6°W). All distances are to a nail and tag in the side of witness object unless otherwise noted.