

APR 07 1998

LAND CORNER RECORDATION CERTIFICATE
Filing Requirement of Act 74, Mich. P.A. 1970
Chippewa County Remonumentation Corner

SECTION

For corners in

Chippewa Located In: Corner Code #

1. Public Land Survey T 46N R 2W C-12
T ___ R ___
T ___ R ___
T ___ R ___

2. Property Controlling S ___ T ___ R ___
in Section S ___ T ___ R ___

3. Miscellaneous S ___ T ___ R ___
Property in Sec. S ___ T ___ R ___

47.00 LAND CORNER
42.00 MSSR
12 Mar 1998 12:42:15 PM Receipt #6527
RECEIVED FOR RECORD
CHIPPEWA COUNTY - STATE OF MICHIGAN
SHARON H. KENNEDY, REGISTER OF DEEDS
BOOK 10 PAGE 224
Register of Deeds Stamp & File Number

4. Lot No. _____, Recorded Plat _____
5. Private Claims _____

I, William L. Karr, in a field survey on November 7, 1997, do hereby state that under requirements of P.A. 74, Michigan P.A. of 1970, the corner points mentioned in lines 1 and 2 above were in conformance with regulations and rules therefore as required in the current manual of survey instructions of the United States Department of the Interior, Bureau of Land Management or by a decree of a Court of Law and/or that the corner points mentioned in lines 3, 4 and 5 above were in conformance with the rules of the Michigan Board of Land Surveyors or by a Decree of a Court of Law; established, re-established, monumented, recovered, found as expressed below:

NOTE: Not more than 2 corners, all in the same town and range, may be recorded on this certificate.

1	A	B	C	D	E	F	G	H	I	J	K	L	M
2		6		5		4		3		2		1	
3													
4		7		8		9		10		11		12	
5													
6		18		17		16		15		14		13	
7													
8		19		20		21		22		23		24	
9													
10		30		29		28		27		26		25	
11													
12		31		32		33		34		35		36	
13													

A. Description of original monument and accessories and/or subsequent restoration:

(C-12) 1/4 Corner Common to Sections 31 and 32, T.46 N., R.2 W.
1849 Harvey Meilen set Tamarack post in original survey.

Witnesses: Tamarack 9 S10°W 24
Spruce 6 S38°W 11

1991 Gerald Wiggins set a 1" pipe mid-way and on-line between the Section corners and established (4) witnesses. Corner was recorded in Liber 7, Page 309 of corner records.

B. Description of corner evidence found and/or method applied in restoring or reestablishing corner:

(C-12) 1/4 Corner Common to Sections 31 and 32, T.46 N., R.2 W.

This corner is being perpetuated as part of the Chippewa County Remonumentation Program.



Found no evidence of the original corner or the 1" pipe set by Wiggins. Found (1) remaining witness. Reestablished the corner by single proportionate measurement (mid-way and on-line) between Sections 29, 30, 31 and 32 and Section corner 31, 32, 5 and 6. Position matched remaining witness.

C. Description of monument for corner and accessories established to perpetuate locating the position of the corner:

(C-12) 1/4 Corner Common to Sections 31 and 32, T.46 N., R.2 W.

Corner is a 3/4" x 24" iron with plastic Chippewa County Remonumentation Corner cap, 8" below grade, 1'± East of centerline of Tilson road and 9'± South of centerline of East-West road.

Witnesses: Mag nail East end of new 20" culvert N55°E 19.68'
Aspen 6" S22°E 87.23'
Tamarack 12" S44°W 129.89' (existing)
Mag nail West end of new 20" culvert N62°W 20.79'

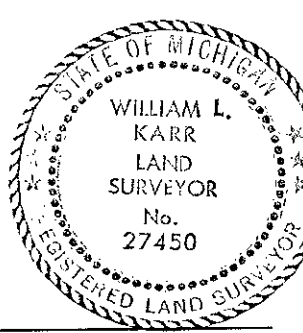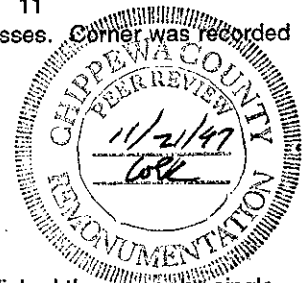

Signed by William L. Karr

Date 12/29/97

Surveyor's Michigan License No. 27450

NOTE: All bearings are compass bearings corrected for declination (6°W). All distances are to a nail and tag in the side of witness object unless otherwise noted.