MAR 2 7 1996

COMMISSION

CHIPPEWA COUNTY REMONUMENTATION CORNER

LAND CORNER RECORDATION CERTIFICATE

Filing Requirement of Act 74, Mich. P.A. 1970

$ 7.00 LAND CORNER
$ 2.00 MSSR
29 FEB 96 9:28 A.M. RECEIPT# 462
RECEIVED FOR RECORD
CHIPPEWA COUNTY - STATE OF MICHIGAN
SHARON H. KENNEDY, REGISTER OF DEEDS

Register of Deeds Stamp & File Number

For corners in Chippewa (County)

	Located In:		Corner Code #
1. Public Land Survey		T46N R2W	C-13 Same
		T45N R2W	C-1 Corner
		T___ R___	
		T___ R___	
2. Property Controlling	S___	T___ R___	
in Section	S___	T___ R___	
3. Miscellaneous	S___	T___ R___	
Property in Sec.	S___	T___ R___	

4. Lot No. _____ , Recorded Plat _____
5. Private Claims _____

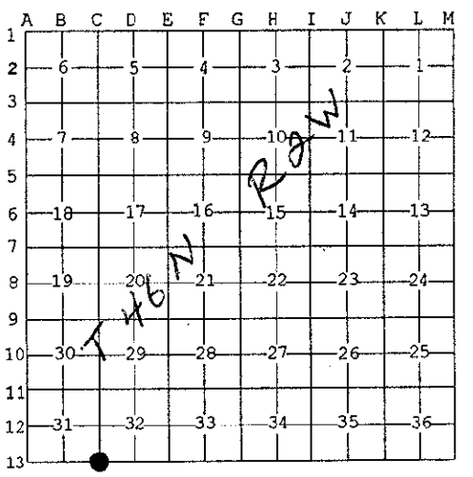

I, Larry R. Rogers, in a field survey on October 23 19 95 do hereby state that under requirements of P.A. 74, Michigan P.A. of 1970, the corner points mentioned in lines 1 and 2 above were in conformance with regulations and rules therefore as required in the current manual of survey instructions of the United States Department of the Interior, Bureau of Land Management or by a decree of a Court of Law and /or that the corner points mentioned in lines 3, 4 and 5 above were in conformance with the rules of the Michigan Board of Land Surveyors or by a Decree of a Court of Law; established, re-established, monumented, recovered, found as expressed below:

NOTE: Not more than 2 corners, all in the same town and range, may be recorded on this certificate.

A. Description of original monument and accessories and/or subsequent restoration:
(C-13) Southwest Corner of Section 32.
1840: Austin Burt "set post corner of Sections 31 and 32" with the following witnesses:
10" Fir N33E 17 links 7" Fir N29W 30 links
1990: Gerald L. Wiggins, P.S. 23521. "Set corner at found iron pin in center line of North and South road", and recorded in Liber 7, Page 245 of the Chippewa County Corner Records with the following witnesses:
7" Red Pine S63°E 37.7' 10" Spruce N25°W 71.3'
6" Spruce N42°E 79.9' 8" Spruce N84°E 52.3'

B. Description of corner evidence found and/or method applied in restoring or reestablishing corner:
(C-13) This corner is being perpetuated as part of the Chippewa County Remonumentation Program.

Found no evidence of original corner position. Found 3/4" iron with D.N.R. plastic cap in centerline of Tilson Road (corner form calls for 1" iron pipe). Recovered four existing witnesses in good shape. Reblazed and set nails in side of trees.

C. Description of monument for corner and accessories established to perpetuate locating the position of the corner:
(C-13) Corner is 3/4" iron pin with plastic D.N.R. cap in centerline of Tilson Road (North-South gravel).

Witnesses:			
	9" Spruce	N42°E	80.10'
	8" Red Pine	S63°E	38.14'
	10" Spruce	N84°W	52.78'
	12" Spruce	N25°W	71.81'
	Wood Post	East	24.33'

STATE OF MICHIGAN
LARRY R. ROGERS
Land Surveyor
NO. 29251
LICENSED LAND SURVEYOR

CHIPPEWA COUNTY
PEER REVIEW
12/1/95
REMONUMENTATION

Signed by _____ 25 DEC 1995

Surveyor's Michigan License No. 29251

NOTE: All bearings are compass bearings corrected for declination. All distances are to a nail in side of witness objects unless otherwise noted.

FORM APPROVED BY MICHIGAN STATE BOARD OF PROFESSIONAL SURVEYORS, JAN. 28, 1971
REVISED MAY 14, 1975
REVISED JAN., 1983
REVISED OCT., 1995