

**LAND CORNER RECORDATION CERTIFICATE**  
**Filing Requirement of Act 74, Mich. P.A. 1970**  
 Chippewa County Remonumentation Corner

APR 07 1998

For corners in

Chippewa

Located In:

Corner Code #

1. Public Land Survey

T 46N R 2W

D-11

T \_\_\_ R \_\_\_

T \_\_\_ R \_\_\_

T \_\_\_ R \_\_\_

T \_\_\_ R \_\_\_

2. Property Controlling in Section

S \_\_\_ T \_\_\_ R \_\_\_

S \_\_\_ T \_\_\_ R \_\_\_

3. Miscellaneous Property in Sec.

S \_\_\_ T \_\_\_ R \_\_\_

S \_\_\_ T \_\_\_ R \_\_\_

47.00 LAND CORNER SECTION

42.00 MSSR

12 Mar 1998 12:42:40 PM Receipt #6527

RECEIVED FOR RECORD

CHIPPewa COUNTY - STATE OF MICHIGAN  
 SHARON H. KENNEDY, REGISTER OF DEEDS

BOOK **10** PAGE **225**


Register of Deeds Stamp & File Number

4. Lot No. \_\_\_\_\_, Recorded Plat \_\_\_\_\_

5. Private Claims \_\_\_\_\_

I, William L. Karr, in a field survey on December 10, 1997, do hereby state that under requirements of P.A. 74, Michigan P.A. of 1970, the corner points mentioned in lines 1 and 2 above were in conformance with regulations and rules therefore as required in the current manual of survey instructions of the United States Department of the Interior, Bureau of Land Management or by a decree of a Court of Law and/or that the corner points mentioned in lines 3, 4 and 5 above were in conformance with the rules of the Michigan Board of Land Surveyors or by a Decree of a Court of Law; established, re-established, monumented, recovered, found as expressed below:

**NOTE: Not more than 2 corners, all in the same town and range, may be recorded on this certificate.**

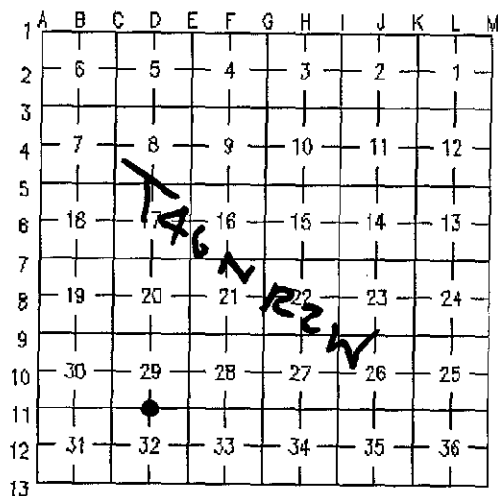

A. Description of original monument and accessories and/or subsequent restoration:

(D-11) 1/4 Corner Common to Sections 29 and 32, T.46 N., R.2 W.

1849 Harvey Mellen set W. Pine post in original survey. Witnesses:

Y. Birch 10      N40°W    14  
 Cedar 10        S10°W     5

Found no record of subsequent restoration.

B. Description of corner evidence found and/or method applied in restoring or reestablishing corner:

(D-11) 1/4 Corner Common to Sections 29 and 32, T.46 N., R.2 W.

This corner is being perpetuated as part of the Chippewa County Remonumentation Program.

Found no evidence of the original corner or subsequent restoration. Reestablished corner by single proportionate measurement (mid-way and on-line) between Section corner 29, 30, 31 and 32 and Section corner 28, 29, 32 and 33. Distance East and West is 2644.18 (GLO - 2657.16).

C. Description of monument for corner and accessories established to perpetuate locating the position of the corner:

(D-11) 1/4 Corner Common to Sections 29 and 32, T.46 N., R.2 W.

Corner is a 2 1/4" O.D. x 8' galvanize pipe with steel fence post inside 4' above grade (water). Corner falls on the Southwesterly side of a large beaver flooding. Placed plastic Chippewa County Remonumentation corner cap on top of fence post.

Witnesses: Spruce 4      N11°E    243.99'  
 Spruce 16"    S65°E    139.89'  
 Spruce 14"    S21°W    68.00'  
 W. Birch (Twin) N23°W    219.87'

Signed by William L. Karr

Date 12/29/97

Surveyor's Michigan License No. 27450

NOTE: All bearings are compass bearings corrected for declination (6°W). All distances are to a nail and tag in the side of witness object unless otherwise noted.

