

MAY 28 1997

LAND CORNER RECORDATION CERTIFICATE

Filing Requirement of Act 74, Mich. P.A. 1970

Chippewa County Remonumentation Corner

\$7.00 LAND CORNER

\$2.00 MSSR

5/4/1997 2:17:41 PM

Receipt #294

For corners in COMMISSION

Chippewa County	Located in:	Corner Code #
1. Public Land Survey	T46N R2W	E-3
	T R	
	T R	
	T R	
2. Property Controlling in Section	S T R	
	S T R	
3. Miscellaneous Property in Sec.	S T R	
	S T R	
4. Lot No. , Recorded Plat		
5. Private Claims		


RECEIVED FOR RECORD  
CHIPPEWA COUNTY - STATE OF MICHIGAN  
SHARON H. KENNEDY, REGISTER OF DEEDS

BOOK 10 PAGE 72

Register of Deeds Stamp & File Number

I, William L. Karr, in a field survey on December 17, 1996, do hereby state that under requirements of P.A. 74, Michigan P.A. of 1970, the corner points mentioned in lines 1 and 2 above were in conformance with regulations and rules therefore as required in the current manual of survey instructions of the United States Department of the Interior, Bureau of Land Management or by a decree of a Court of Law and/or that the corner points mentioned in lines 3, 4 and 5 above were in conformance with the rules of the Michigan Board of Land Surveyors or by a Decree of a Court of Law; established, re-established, monumented, recovered, found as expressed below:

NOTE: Not more than 2 corners, all in the same town and range, may be recorded on this certificate.

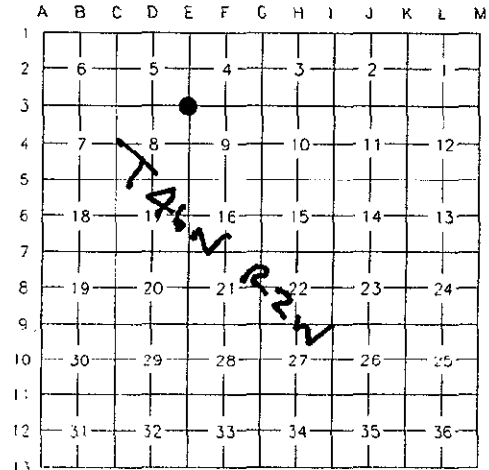

A. Description of original monument and accessories and/or subsequent restoration:

(E-3) Section Corner Common to Sections 4, 5, 8 & 9, T. 46 N., R. 2 W.

1849 H. Meilen set post in original survey.

Witnesses: Yellow Birch 10 S 46° E 24 lks  
Yellow Birch 8 N 02° W 16 lks

1974 J.P. Smallwood, working for Michigan Dept. of State Highways, found a 1 1/4" steel pin in monument box in road intersection. The corner was recorded by N.C. Jones, PS 2934, in Liber 1, Page 109, Chippewa County Corner Records.

1978 T.M. Kelly, PS 24599, found 3/4" iron in monument box in road intersection with one remaining witness from 1974. Re-recorded corner in Liber 1, Page 294, Chippewa County corner Records.

B. Description of corner evidence found and/or method applied in restoring or reestablishing corner:

(E-3) Section Corner Common to Sections 4, 5, 8 & 9, T. 46 N., R. 2 W.

This corner is being perpetuated as part of the Chippewa County Remonumentation Program.

Found 3/4" iron in monument box at the position recorded by Jones in 1974, and Kelly in 1978. Accepted corner position as found.



C. Description of monument for corner and accessories established to perpetuate locating the position of the corner:

(E-3) Section Corner Common to Sections 4, 5, 8 & 9, T. 46 N., R. 2 W.

Corner is a 3/4" iron in monument box. Corner falls in the intersecting centerlines of M-221, North-South, and Crawford St., East-West.

Witnesses: S.W. Corner of Post Office N 34° E 77.68'  
Power Pole (E20) S 54° E 42.36'  
Power Pole (E21/25A) S 56° W 35.25'  
S.E. Foundation Corner of Congregational Church N 49° W 79.08'

Bearings are compass bearings, corrected for declination, all distances are to a nail and tag in the side of the witness object unless otherwise noted.

Signed by William L. Karr

Date 12-30-96

Surveyor's Michigan License No. 27450

