

CHIPPEWA COUNTY REMONUMENTATION CORNER

MAR 27 1996

LAND CORNER RECORDATION CERTIFICATE  
Filing Requirement of Act 74, Mich. P.A. 1970

COMMISSION

For corners in

Chippewa  
(County)

Located In:

Corner Code #

1. Public Land Survey

T46N R2W E-7

T R

T R

T R

2. Property Controlling in Section

S T R

S T R

3. Miscellaneous Property in Sec.

S T R

S T R

\$ 7.00 LAND CORNER

\$ 2.00 MSSR

29 FEB 96 9:29 A.M.

RECEIPT# 462

RECEIVED FOR RECORD


CHIPPEWA COUNTY - STATE OF MICHIGAN  
SHARON H. KENNEDY, REGISTER OF DEEDS

Register of Deeds Stamp & File Number

4. Lot No. \_\_\_\_\_, Recorded Plat \_\_\_\_\_  
5. Private Claims \_\_\_\_\_

I, Larry R. Rogers, in a field survey on Oct. 10, 1995 do hereby state that under requirements of P.A. 74, Michigan P.A. of 1970, the corner points mentioned in lines 1 and 2 above were in conformance with regulations and rules therefore as required in the current manual of survey instructions of the United States Department of the Interior, Bureau of Land Management or by a decree of a Court of Law and /or that the corner points mentioned in lines 3, 4 and 5 above were in conformance with the rules of the Michigan Board of Land Surveyors or by a Decree of a Court of Law, established, re-established, monumented, recovered, found as expressed below:

NOTE: Not more than 2 corners, all in the same town and range, may be recorded on this certificate.

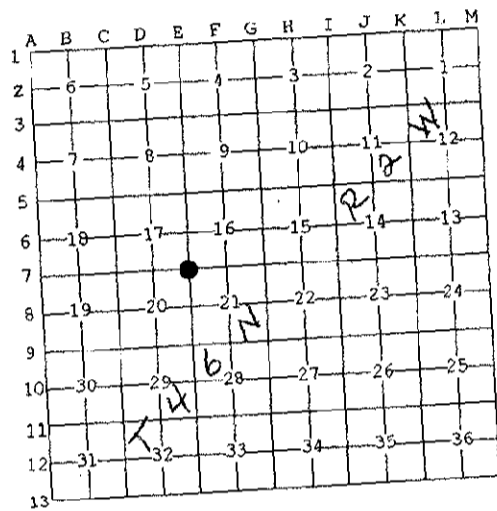

A. Description of original monument and accessories and/or subsequent restoration:  
(E-7) Southeast Corner of Section 17, T46N, R2W


- 1849: Harvey Mellen "set spruce post at corner" with the following witnesses:  
10" Spruce S28E 23 links 8" Sugar N46W 36 links
- 1988: Neil E. Hill, P.S. 27447 found 1/2" rerod in monument box 0.85 feet South of centerline of M-28 as referenced in 1946 Highway Plans (L-55-B-5) and recorded in L.7, Pg.82 of the Chippewa County Corner Records with the following witnesses:  
MDOT Tag in wood post N50°E 86.22' Nail & flag in P.P. S35°W 65.06'  
MDOT Tag in Light Pole N30°W 89.50' Nail & flag in White Pine S67°E 176.05'  
Top center of conc. project marker N35°E 75.08'

B. Description of corner evidence found and/or method applied in restoring or reestablishing corner:  
(E-7) This corner is being perpetuated as part of the Chippewa County Remonumentation Program.

Found 1/2" rerod with cap #27447 in monument box, 0.9 feet South of the centerline of State Highway M-28 and in line with the centerline of State Highway M-221 to the North. Recovered five witnesses from previous recording (Southeast wood post not recovered). All distances check well.

C. Description of monument for corner and accessories established to perpetuate locating the position of the corner:  
(E-7) Corner is 1/2" rerod with cap #27447 in monument box 0.9 feet South of centerline of M-28 and on the extension of the centerline of M-221 to the North.

- Witnesses:
- Light Pole (F84) N33°W 89.58'
  - Center of conc. right-of-way marker N35°E 76.24'
  - Cut off utility pole N49°E 86.15'
  - 12" White Pine S68°E 176.04'
  - Utility Pole S28°E 64.96'

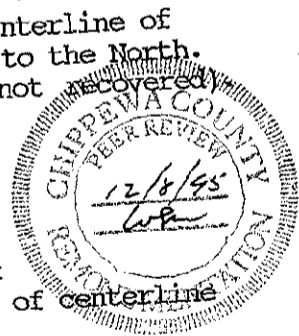

Signed by [Signature]  
Surveyor's Michigan License No. 29251

Date 30 DEC 1995

NOTE: Bearings are compass bearings corrected for declination. Distances are to a nail in side of witness objects unless noted.

FORM APPROVED BY MICHIGAN STATE BOARD OF PROFESSIONAL SURVEYORS, JAN. 28, 1971  
REVISED MAY 14, 1975  
REVISED JAN., 1983  
REVISED OCT., 1986