

APR 07 1998

LAND CORNER RECORDATION CERTIFICATE
 Filing Requirement of Act 74, Mich. P.A. 1970
 Chippewa County Remonumentation Corner

\$7.00 LAND CORRECTION

\$2.00 MSSR
 12 Mar 1998 12:43:05 PM Receipt #6527

RECEIVED FOR RECORD
 CHIPPWEA COUNTY - STATE OF MICHIGAN
 SHARON H. KENNEDY, REGISTER OF DEEDS

BOOK 10 PAGE 226

Register of Deeds Stamp & File Number

For corners in

Chippewa

Located In:

Corner Code #

- | | | | |
|------------------------------------|--------------|-------------|-------------|
| 1. Public Land Survey | T <u>46N</u> | R <u>2W</u> | <u>E-10</u> |
| | T _____ | R _____ | |
| | T _____ | R _____ | |
| | T _____ | R _____ | |
| 2. Property Controlling in Section | S _____ | T _____ | R _____ |
| | S _____ | T _____ | R _____ |
| 3. Miscellaneous Property in Sec. | S _____ | T _____ | R _____ |
| | S _____ | T _____ | R _____ |

4. Lot No. _____, Recorded Plat _____
 5. Private Claims _____

I, William L. Karr, in a field survey on November 26, 1997, do hereby state that under requirements of P.A. 74, Michigan P.A. of 1970, the corner points mentioned in lines 1 and 2 above were in conformance with regulations and rules therefore as required in the current manual of survey instructions of the United States Department of the Interior, Bureau of Land Management or by a decree of a Court of Law and/or that the corner points mentioned in lines 3, 4 and 5 above were in conformance with the rules of the Michigan Board of Land Surveyors or by a Decree of a Court of Law; established, re-established, monumented, recovered, found as expressed below:

NOTE: Not more than 2 corners, all in the same town and range, may be recorded on this certificate.


	A	B	C	D	E	F	G	H	I	J	K	L	M
1													
2		6		5		4		3		2		1	
3													
4		7		8		9		10		11		12	
5													
6		18		17		16		15		14		13	
7													
8		19		20		21		22		23		24	
9													
10		30		29		28		27		26		25	
11													
12		31		32		33		34		35		36	
13													

A. Description of original monument and accessories and/or subsequent restoration:

(E-10) 1/4 Corner Common to Sections 28 and 29, T.46 N., R.2 W.
 1849 Harvey Mellen set Maple post in original survey. Witnesses:

Sugar 9" S05°W 47
 Sugar 12 N08°E 65

Found no record of subsequent restoration.

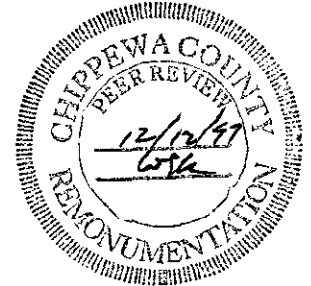

B. Description of corner evidence found and/or method applied in restoring or reestablishing corner:


(E-10) 1/4 Corner Common to Sections 28 and 29, T.46 N., R.2 W.
 This corner is being perpetuated as part of the Chippewa County Remonumentation Program.

Found no evidence of the original corner or subsequent restoration. Found a North-South fence line in the general vicinity. Did not find any evidence that the fence was built based on a survey or found corner. Did not accept the fence as evidence of the Section line. Reestablished the corner by single proportionate measurement (mid-way and on-line) between Section corner 20, 21, 28 and 29 and Section corner 28, 29, 32 and 33. Distance North and South is 2636.69' (GLO - 2640').

C. Description of monument for corner and accessories established to perpetuate locating the position of the corner:

(E-10) 1/4 Corner Common to Sections 28 and 29, T.46 N., R.2 W.
 Corner is a 3/4" x 24" iron with stamped aluminum Chippewa County Remonumentation Corner cap. Corner falls 30'± West of a North-South fence. Placed a steel fence post 1.0' North.

Witnesses: Spruce 8" N33°E 46.43'
 Aspen 6" S09°W 60.95'
 Aspen 9" S44°W 28.11'
 Aspen 7" N25°W 47.21'

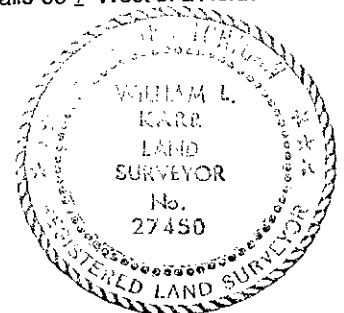

Signed by William L. Karr

Date 12/29/97

Surveyor's Michigan License No. 27450

NOTE: All bearings are compass bearings corrected for declination (6°W). All distances are to a nail and tag in the side of witness object unless otherwise noted.