

APR 07 1998

LAND CORNER RECORDATION CERTIFICATE
Filing Requirement of Act 74, Mich. P.A. 1970
Chippewa County Remonumentation Corner

SECTION

For corners in

Chippewa

Located In:

Corner Code #

1. Public Land Survey

T 46N R 2W

E-12

T ___ R ___

T ___ R ___

T ___ R ___

2. Property Controlling in Section

S ___ T ___ R ___

S ___ T ___ R ___

3. Miscellaneous Property in Sec.

S ___ T ___ R ___

S ___ T ___ R ___

4. Lot No. _____, Recorded Plat _____

5. Private Claims _____

I, William L. Karr, in a field survey on November 26, 1997, do hereby state that under requirements of P.A. 74, Michigan P.A. of 1970, the corner points mentioned in lines 1 and 2 above were in conformance with regulations and rules therefore as required in the current manual of survey instructions of the United States Department of the Interior, Bureau of Land Management or by a decree of a Court of Law and/or that the corner points mentioned in lines 3, 4 and 5 above were in conformance with the rules of the Michigan Board of Land Surveyors or by a Decree of a Court of Law; established, re-established, monumented, recovered, found as expressed below:

NOTE: Not more than 2 corners, all in the same town and range, may be recorded on this certificate.

\$7.00 LAND CORNER

\$2.00 MSSR

12 Mar 1998 12:43:56 PM Receipt #6527

RECEIVED FOR RECORD

CHIPPEWA COUNTY - STATE OF MICHIGAN
SHARON H. KENNEDY, REGISTER OF DEEDS

BOOK 10 PAGE 228

Register of Deeds Stamp & File Number

A	B	C	D	E	F	G	H	I	J	K	L	M
1												
2	6		5		4		3		2		1	
3												
4	7		8		9		10		11		12	
5												
6	18		17		16		15		14		13	
7												
8	19		20		21		22		23		24	
9												
10	30		29		28		27		26		25	
11												
12	31		32		33		34		35		36	
13												

A. Description of original monument and accessories and/or subsequent restoration:

(E-12) 1/4 Corner Common to Sections 32 and 33, T.46 N., R.2 W.
1849 Harvey Mellen set Birch post in original survey.

Witnesses:

Y. Birch 12
Y. Birch 5

N37°E 10
S40°W 15

Found no record of subsequent restoration.

B. Description of corner evidence found and/or method applied in restoring or reestablishing corner:



(E-12) 1/4 Corner Common to Sections 32 and 33, T.46 N., R.2 W.
This corner is being perpetuated as part of the Chippewa County Remonumentation Program.

Found no evidence of the original corner or subsequent restoration. Found multiple fencelines in the area (East-West and North-South). Did not find any evidence that any of the fences were built by survey. Did not accept fences as evidence. Reestablished the corner by single proportionate measurement (mid-way and on-line) between Section corner 32, 33, 4 and 5 and Section corner 28, 29, 32 and 33. Distance North and South is 2637.22' (GLO - 2640.00').

C. Description of monument for corner and accessories established to perpetuate locating the position of the corner:

(E-12) 1/4 Corner Common to Sections 32 and 33, T.46 N., R.2 W.
Corner is a 3/4" x 24" iron with stamped aluminum Chippewa County Remonumentation Corner cap, 150'± Southwest of Southwest corner of old farm field. Steel fence post placed 1.0' North.

Witnesses: Twin Maple 5" N08°E 20.48'
Multiple Maple 8" N58°E 38.31'
3/4" I.D. capped witness pipe S50°E 27.79'
Aspen 12" S22°W 33.55'

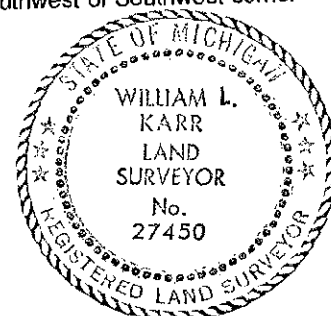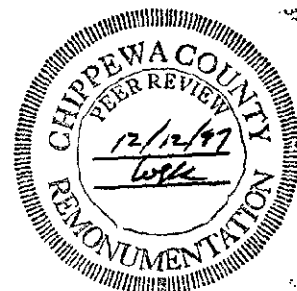

Signed by

William L. Karr

Date

12/29/97

Surveyor's Michigan License No. 27450

NOTE: All bearings are compass bearings corrected for declination (6°W). All distances are to a nail and tag in the side of witness object unless otherwise noted.

FORM APPROVED BY MICHIGAN STATE BOARD OF PROFESSIONAL SURVEYORS, JAN. 28, 1971
REVISED MAY 14, 1975
REVISED JAN., 1983
REVISED OCT., 1995

BOOK 10 PAGE 228