

MAY 28 1997

COMMISSION

For corners in

Chippewa County Located in: Corner Code #

1. Public Land Survey		T46N	R2W	G-8
		T	R	
		T	R	
		T	R	
2. Property Controlling in Section	S	T	R	
	S	T	R	
3. Miscellaneous Property in Sec.	S	T	R	
	S	T	R	


4. Lot No. , Recorded Plat  
5. Private Claims

**LAND CORNER RECORDATION CERTIFICATE**  
Filing Requirement of Act 74, Mich. P.A. 1970

LAND CORNER  
\$2.00 MSSR  
3/4/1997 2:32:56 PM Receipt #294  
RECEIVED FOR RECORD  
CHIPPEWA COUNTY - STATE OF MICHIGAN  
SHARON H. KENNEDY, REGISTER OF DEEDS

BOOK 10 PAGE 86

Register of Deeds Stamp & File Number

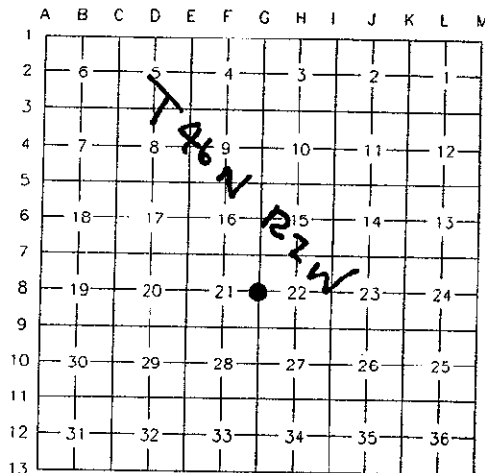

I, William L. Karr, in a field survey on December 18, 1996, do hereby state that under requirements of P.A. 74, Michigan P.A. of 1970, the corner points mentioned in lines 1 and 2 above were in conformance with regulations and rules therefore as required in the current manual of survey instructions of the United States Department of the Interior, Bureau of Land Management or by a decree of a Court of Law and/or that the corner points mentioned in lines 3, 4 and 5 above were in conformance with the rules of the Michigan Board of Land Surveyors or by a Decree of a Court of Law; established, re-established, monumented, recovered, found as expressed below:

NOTE: Not more than 2 corners, all in the same town and range, may be recorded on this certificate.

A. Description of original monument and accessories and/or subsequent restoration:

(G-8) 1/4 Corner Common to Sections 21 & 22, T. 46 N., R. 2 W.

1849 H. Mellen set spruce post in original survey.

Witnesses: Spruce 6 N 65° E 21 lks  
Spruce 8 S 56° W 18 lks

B. Description of corner evidence found and/or method applied in restoring or reestablishing corner:

(G-8) 1/4 Corner Common to Sections 21 & 22, T. 46 N., R. 2 W.

This corner is being reestablished as part of the Chippewa County Remonumentation Program.

Found no evidence of original corner or subsequent restoration.

Reestablished position on-line between the section corners to the North and South, and on the range of a fence line to the West. Distance North is 2629.59'; Distance South is 2610.87'.

C. Description of monument for corner and accessories established to perpetuate locating the position of the corner:

(G-8) 1/4 Corner Common to Sections 21 & 22, T. 46 N., R. 2 W.

Corner is a 3/4" x 24" re-bar with plastic Chippewa County Remonumentation Cap. Corner falls in the centerline of Bound Road, North-South, and on the range of a fence line to the West.

Witnesses: Power Pole N 13° E 286.62'  
Power Pole S 55° E 57.77'  
6" Tamarack S 52° W 72.88'  
6" Tamarack N 87° W 146.00'

Bearings are compass bearings, corrected for declination, all distances are to a nail and tag in the side of the witness object unless otherwise noted.

Signed by William L. Karr

Date 12-30-96

Surveyor's Michigan License No. 27450

