

APR 07 1998

LAND CORNER RECORDATION CERTIFICATE
Filing Requirement of Act 74, Mich. P.A. 1970
Chippewa County Remonumentation Corner

SECTION

For corners in

Chippewa

Located In:

Corner Code #

1. Public Land Survey

T 46N R 2W

G-12

T ___ R ___

T ___ R ___

T ___ R ___

2. Property Controlling
in Section

S ___ T ___ R ___

S ___ T ___ R ___

3. Miscellaneous
Property in Sec.

S ___ T ___ R ___

S ___ T ___ R ___

4. Lot No. _____, Recorded Plat _____

5. Private Claims _____

I, William L. Karr, in a field survey on December 1, 1997, do hereby state that under requirements of P.A. 74, Michigan P.A. of 1970, the corner points mentioned in lines 1 and 2 above were in conformance with regulations and rules therefore as required in the current manual of survey instructions of the United States Department of the Interior, Bureau of Land Management or by a decree of a Court of Law and/or that the corner points mentioned in lines 3, 4 and 5 above were in conformance with the rules of the Michigan Board of Land Surveyors or by a Decree of a Court of Law; established, re-established, monumented, recovered, found as expressed below:

NOTE: Not more than 2 corners, all in the same town and range, may be recorded on this certificate.

\$7.00 LAND CORNER

\$2.00 NGSSR

12 Mar 1998 12:47:05 PM Receipt #6527

RECEIVED FOR RECORD

CHIPPEWA COUNTY - STATE OF MICHIGAN
SHARON H. KENNEDY, REGISTER OF DEEDS

BOOK 10 PAGE 233

Register of Deeds Stamp & File Number

A	B	C	D	E	F	G	H	I	J	K	L	M
1												
2	6	5	4	3	2	1						
3												
4	7	8	9	10	11	12						
5												
6	18	17	16	15	14	13						
7												
8	19	20	21	22	23	24						
9												
10	30	29	28	27	26	25						
11												
12	31	32	33	34	35	36						
13												

A. Description of original monument and accessories and/or subsequent restoration:

(G-12) 1/4 Corner Common to Sections 33 and 34, T.46 N., R.2 W.

1849 Harvey Mellen set Maple post in original survey. Witnesses:

Spruce 9

N25°E 19

Aspen 9

S64°W 30

???? County Surveyor notes show a fence East at 2647' (North of Town Line) and overall mile as 5267'. There was a note that the fence was not set on the East-West 1/4 line.

B. Description of corner evidence found and/or method applied in restoring or reestablishing corner:

(G-12) 1/4 Corner Common to Sections 33 and 34, T.46 N., R.2 W.

This corner is being perpetuated as part of the Chippewa County Remonumentation Program.

Found no evidence of the original corner or subsequent restoration. Did not find any remains of the fence line to the East. Reestablished corner position by single proportionate measurement (mid-way and on-line). Distance North and South is 2637.21' (GLO - 2640.00').

C. Description of monument for corner and accessories established to perpetuate locating the position of the corner:


(G-12) 1/4 Corner Common to Sections 33 and 34, T.46 N., R.2 W.

Corner is a 3/4" x 24" iron with plastic Chippewa County Remonumentation Corner cap, 1.5'± West of centerline of Bound road.

Witnesses: Power pole N25°E 106.10'
3/4" capped witness pipe S50°E 54.47'
3/4" capped witness pipe S42°W 52.14'
Fence post N29°W 99.68'

Signed by William L. Karr

Date 12/29/97

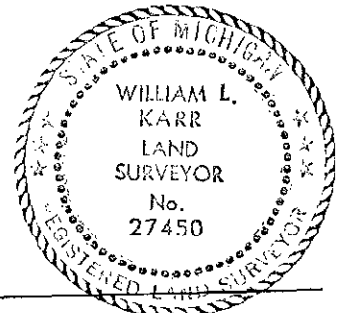

Surveyor's Michigan License No. 27450

NOTE: All bearings are compass bearings corrected for declination (6°W). All distances are to a nail and tag in the side of witness object unless otherwise noted.