

APR 07 1998

LAND CORNER RECORDATION CERTIFICATE
Filing Requirement of Act 74, Mich. P.A. 1970
Chippewa County Remonumentation Corner

SECTION


For corners in

Table with columns: Chippewa, Located In:, Corner Code #. Rows include Public Land Survey, Property Controlling in Section, and Miscellaneous Property in Sec.

Register of Deeds Stamp & File Number. Includes \$7.00 LAND CORNER, \$2.00 MSSR, 12 Mar 1998 12:47:30 PM Receipt #6527, RECEIVED FOR RECORD, CHIPPewa COUNTY - STATE OF MICHIGAN, SHARON H. KENNEDY, REGISTER OF DEEDS, BOOK 10 PAGE 234.

4. Lot No. _____, Recorded Plat _____
5. Private Claims _____

I, William L. Karr, in a field survey on December 3, 1997, do hereby state that under requirements of P.A. 74, Michigan P.A. of 1970, the corner points mentioned in lines 1 and 2 above were in conformance with regulations and rules therefore as required in the current manual of survey instructions of the United States Department of the Interior, Bureau of Land Management or by a decree of a Court of Law and/or that the corner points mentioned in lines 3, 4 and 5 above were in conformance with the rules of the Michigan Board of Land Surveyors or by a Decree of a Court of Law; established, re-established, monumented, recovered, found as expressed below:

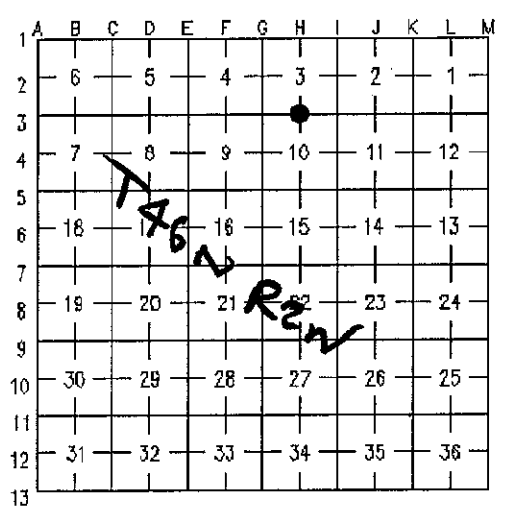

NOTE: Not more than 2 corners, all in the same town and range, may be recorded on this certificate.

A. Description of original monument and accessories and/or subsequent restoration:

(H-3) 1/4 Corner Common to Sections 3 and 10, T.46 N., R.2 W.
1849 Harvey Mellen set Cedar post in original survey.

Witnesses: Spruce 16 N68°E 32
Hemlock 14 S53°W 24

Found no record of subsequent restoration.

B. Description of corner evidence found and/or method applied in restoring or reestablishing corner:

(H-3) 1/4 Corner Common to Sections 3 and 10, T.46 N., R.2 W.
This corner is being perpetuated as part of the Chippewa County Remonumentation Program.

Found no evidence of the original corner or subsequent restoration. Reset the corner by single proportionate measurement (mid-way and on-line) between Section corner 2, 3, 10 and 11 and Section corner 3, 4, 9 and 10. Distance East and West is 2648.09' (GLO is 2649.90').

C. Description of monument for corner and accessories established to perpetuate locating the position of the corner:

(H-3) 1/4 Corner Common to Sections 3 and 10, T.46 N., R.2 W.
Corner is a 3/4" x 24" iron with stamped aluminum Chippewa County Remonumentation Corner cap. Placed a metal fence post 1.0' North of corner. Corner is 6" above grade.

Witnesses: Balsam 8" N64°E 17.17'
Maple 6" S45°W 16.27'
Spruce 18" S84°W 58.56'
Spruce 10" N05°W 26.18'

Signed by [Signature]

Date 12/25/97

Surveyor's Michigan License No. 27450

NOTE: All bearings are compass bearings corrected for declination (6°W). All distances are to a nail and tag in the side of witness object unless otherwise noted.

