

CHIPPEWA COUNTY REMONUMENTATION CORNER

MAR 27 1996

LAND CORNER RECORDATION CERTIFICATE
Filing Requirement of Act 74, Mich. P.A. 1970

For corners in COMMISSION

Chippewa Located In: Corner Code #
(County)

1. Public Land Survey T46N R2W H-7
T R
T R
T R
T R

2. Property Controlling in Section S T R
S T R

3. Miscellaneous Property in Sec. S T R
S T R

\$ 7.00 LAND CORNER
\$ 2.00 MSSR
29 FEB 96 9:32 A.M. RECEIPT# 462
RECEIVED FOR RECORD
CHIPPEWA COUNTY - STATE OF MICHIGAN
SHARON H. KENNEDY, REGISTER OF DEEDS

Register of Deeds Stamp & File Number

4. Lot No. _____, Recorded Plat _____
5. Private Claims _____

I, Larry R. Rogers in a field survey on Oct. 10, 19 95 do hereby state that under requirements of P.A. 74, Michigan P.A. of 1970, the corner points mentioned in lines 1 and 2 above were in conformance with regulations and rules therefore as required in the current manual of survey instructions of the United States Department of the Interior, Bureau of Land Management or by a decree of a Court of Law and /or that the corner points mentioned in lines 3, 4 and 5 above were in conformance with the rules of the Michigan Board of Land Surveyors or by a Decree of a Court of Law; established, re-established, monumented, recovered, found as expressed below:

A	B	C	D	E	F	G	H	I	J	K	L	M
1												
2	6		5		4		3	N	2			1
3												
4	7		8		9		10		11			12
5												
6	18		17		16		15		14			13
7												
8	19	H	20		21		22		23			24
9												
10	30		29		28		27		26			25
11												
12	31		32		33		34		35			36
13												

NOTE: Not more than 2 corners, all in the same town and range, may be recorded on this certificate.

A. Description of original monument and accessories and/or subsequent restoration:

(H-7) South 1/4 Corner of Section 15, T46N, R2W

1849: Harvey Mellen "set Birch post Qr. Section Corner" with the following witnesses:
12" Y. Birch N38E 44 links 6" Y. Birch S38W 26 links

1900±: County Surveyor notes recite distances of 2644 feet to Southwest Section Corner and 2625 feet to Southeast Section Corner.

B. Description of corner evidence found and/or method applied in restoring or reestablishing corner:


(H-7) This corner is being perpetuated as part of Chippewa County Remonumentation program.

Found no evidence of original corner position. Distance from Southeast corner of Section 15 to Southwest corner is 5268.54 (Co. Surv. 5269). Re-established 1/4 corner on-line between Southwest and Southeast corners of Section 15 at prorated distance based on 1900 county surveyor distances.

C. Description of monument for corner and accessories established to perpetuate locating the position of the corner:

(H-7) Corner is 3/4"x 24" iron with plastic "Chippewa County Remonumentation" cap feet North of the centerline of State Highway M-28.

Witnesses: 10" Twin Spruce N79°E 189.87'
5" White Pine N75°W 173.66'
7" White Pine S38°W 65.32'
Utility Pole (DR4/120) S48°E 144.87'

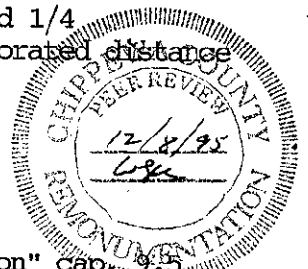

Signed by _____
Surveyor's Michigan License No. 29251

Date 30 DEC 1995

NOTE: Bearings are compass bearings corrected for declination. Distances are to a nail in side of witness objects unless noted.

FORM APPROVED BY MICHIGAN STATE BOARD OF PROFESSIONAL SURVEYORS, JAN. 28, 1971
REVISED MAY 14, 1975
REVISED JAN., 1983
REVISED OCT., 1985