

SURVEY &
REMONUMENTATION

LAND CORNER RECORDATION CERTIFICATE
Filing Requirement of Act 74, Mich. P.A. 1970
Chippewa County Remonumentation Corner

APR 07 1998

For corners in


SECTION

<u>Chippewa</u>	Located In:	Corner Code #
1. Public Land Survey	T <u>46N</u> R <u>2W</u>	<u>H-11</u>
	T _____ R _____	
	T _____ R _____	
	T _____ R _____	
2. Property Controlling in Section	S _____ T _____ R _____	
	S _____ T _____ R _____	
3. Miscellaneous Property in Sec.	S _____ T _____ R _____	
	S _____ T _____ R _____	

\$7.00 LAND CORNER
\$2.00 MSSR
12 Mar 1998 12:52:49 PM Receipt #6527
RECEIVED FOR RECORD
CHIPPEWA COUNTY - STATE OF MICHIGAN
SHARON H. KENNEDY, REGISTER OF DEEDS
BOOK 10 PAGE 235
Register of Deeds Stamp & File Number

4. Lot No. _____, Recorded Plat _____
5. Private Claims _____

I, William L. Karr, in a field survey on December 2, 1997, do hereby state that under requirements of P.A. 74, Michigan P.A. of 1970, the corner points mentioned in lines 1 and 2 above were in conformance with regulations and rules therefore as required in the current manual of survey instructions of the United States Department of the Interior, Bureau of Land Management or by a decree of a Court of Law and/or that the corner points mentioned in lines 3, 4 and 5 above were in conformance with the rules of the Michigan Board of Land Surveyors or by a Decree of a Court of Law; established, re-established, monumented, recovered, found as expressed below:

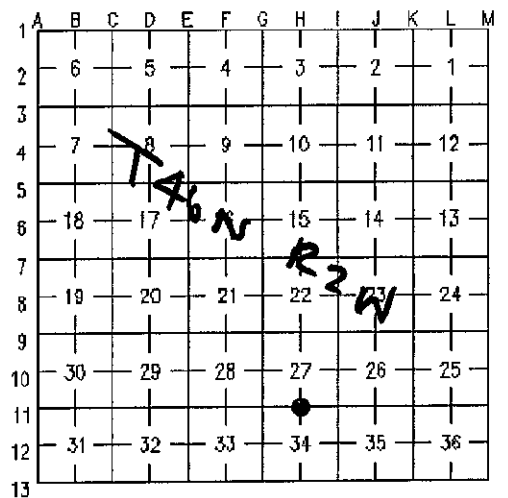

NOTE: Not more than 2 corners, all in the same town and range, may be recorded on this certificate.

A. Description of original monument and accessories and/or subsequent restoration:

(H-11) 1/4 Corner Common to Sections 27 and 34, T.46 N., R.2 W.
1849 Harvey Mellen set Birch post in original survey.

Witnesses:

Maple 4" S80°E 12
Spruce 5" N55°W 10

Found no record of subsequent restoration.

B. Description of corner evidence found and/or method applied in restoring or reestablishing corner:

(H-11) 1/4 Corner Common to Sections 27 and 34, T.46 N., R.2 W.
This corner is being perpetuated as part of the Chippewa County Remonumentation Program.

Found no evidence of the original corner or subsequent restoration. Reestablished corner by single proportionate measurement (mid-way and on-line) between Section corner 26, 27, 34 and 35 and Section corner 27, 28, 33 and 34. Distance East and West is 2640.92' (GLO is 2653.86).

C. Description of monument for corner and accessories established to perpetuate locating the position of the corner:

(H-11) 1/4 Corner Common to Sections 27 and 34, T.46 N., R.2 W.

Corner is a 3/4" x 24" iron with stamped aluminum Chippewa County Remonumentation Corner cap. Corner falls on West Edge of North-South ditch and 15'± South of East-West ditch and 20'± South of an East-West fence line.

Witnesses:	3/4" I.D. capped witness pipe	N30°E	40.83'
	Spruce 4"	S80°E	3.15'
	Fence post	S22°W	29.41'
	3/4" I.D. capped witness pipe	N24°W	36.36'

Signed by William L. Karr

Date 12/24/97

Surveyor's Michigan License No. 27450

NOTE: All bearings are compass bearings corrected for declination (6°W). All distances are to a nail and tag in the side of witness object unless otherwise noted.

