

CHIPPEWA COUNTY REMONUMENTATION CORNER

MAR 27 1996

COMMISSIONER

LAND CORNER RECORDATION CERTIFICATE  
Filing Requirement of Act 74, Mich. P.A. 1970

For corners in

Chippewa Located In: Corner Code #  
(County)

1. Public Land Survey T 46NR 2W H-13 Same  
T 45NR 2W H-1 Corner  
T \_\_\_ R \_\_\_  
T \_\_\_ R \_\_\_

2. Property Controlling S \_\_\_ T \_\_\_ R \_\_\_  
in Section S \_\_\_ T \_\_\_ R \_\_\_

3. Miscellaneous S \_\_\_ T \_\_\_ R \_\_\_  
Property in Sec. S \_\_\_ T \_\_\_ R \_\_\_

\$ 7.00 LAND CORNER  
\$ 2.00 MSSR  
29 FEB 96 9:32 A.M. RECEIPT# 462  
RECEIVED FOR RECORD  
CHIPPEWA COUNTY - STATE OF MICHIGAN  
SHARON H. KENNEDY, REGISTER OF DEEDS

Register of Deeds Stamp & File Number

4. Lot No. \_\_\_\_\_, Recorded Plat \_\_\_\_\_  
5. Private Claims \_\_\_\_\_

I, Larry R. Rogers, in a field survey on Oct. 23, 1995 do hereby state that under requirements of P.A. 74, Michigan P.A. of 1970, the corner points mentioned in lines 1 and 2 above were in conformance with regulations and rules therefore as required in the current manual of survey instructions of the United States Department of the Interior, Bureau of Land Management or by a decree of a Court of Law and/or that the corner points mentioned in lines 3, 4 and 5 above were in conformance with the rules of the Michigan Board of Land Surveyors or by a Decree of a Court of Law; established, re-established, monumented, recovered, found as expressed below:

NOTE: Not more than 2 corners, all in the same town and range, may be recorded on this certificate.

	A	B	C	D	E	F	G	H	I	J	K	L	M
1													
2		6		5		4		3		2	1		
3										2	1		
4		7		8		9		10		11	12		
5													
6		18		17		16		15		14	13		
7													
8		19		20		21		22		23	24		
9													
10		30		29		28		27		26	25		
11													
12		31		32		33		34		35	36		
13													

A. Description of original monument and accessories and/or subsequent restoration:

(H-13) South 1/4 Corner of Section 34, T46N, R2W

1840: Austin Burt "set quarter section post" with the following witnesses:  
8" Fir N78°E 46 links 16" Cedar N47°W 22 links

1921: County Surveyor F.H. Brown does not identify corner monument, but gives distance of 2632 feet East and west to adjacent section corners.

1980: County Surveyor Rudy Larson, P.S. 3644 identifies corners as an iron pipe 2632 feet East and West of Southwest corner of Section 34.

B. Description of corner evidence found and/or method applied in restoring or reestablishing corner:

(H-13) This corner is being perpetuated as part of the Chippewa County Remonumentation program.

Found iron pipe used in 1980 Larson survey 2632.5 feet East of Southwest corner of Section 34 prior to road paving. Corner has been used by several other surveyors since 1980, but never recorded. Corner removed during road paving. Re-established corner position as previously located from existing survey control and established new witnesses.


C. Description of monument for corner and accessories established to perpetuate locating the position of the corner:

(H-13) Corner is a 3/4"x24" iron with plastic "Chippewa County Remonumentation" cap in centerline of 12 Mile Road (asphalt).

Witnesses: 15" Spruce N23°W 46.37'  
15" Red Pine N21°E 48.24'  
8" Balsam Fir S40°E 79.95'  
Utility Pole S70°W 86.68'

Signed by \_\_\_\_\_  
Surveyor's Michigan License No. 29251

Date 27 DEC 1995

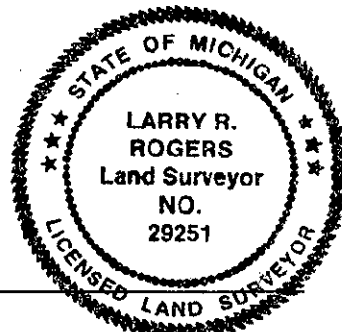

NOTE: Bearings are compass bearings corrected for declination. Distances are to a nail in side of witness objects unless noted. FORM APPROVED BY MICHIGAN STATE BOARD OF PROFESSIONAL SURVEYORS, JAN. 28, 1971  
REVISED MAY 14, 1975  
REVISED JAN., 1983  
REVISED OCT., 1985