

DEC 18 1995

COMMISSION

LAND CORNER RECORDATION CERTIFICATE

Filing Requirement of Act 74, Mich. P.A. 1970

For corners in

Chippewa (County)

Located In:

Corner Code #

- 1. Public Land Survey T-46N R-2W I-1 Same I-13/Corner
2. Property Controlling in Section S-T-R
3. Miscellaneous Property in Sec. S-T-R


RECEIVED FOR RECORD CHIPPEWA COUNTY STATE OF MICHIGAN

94 JUL 22 AM 11:17

J. Roger Malick REGISTER OF DEEDS

Register of Deeds Stamp & File Number

- 4. Lot No. Recorded Plat
5. Private Claims

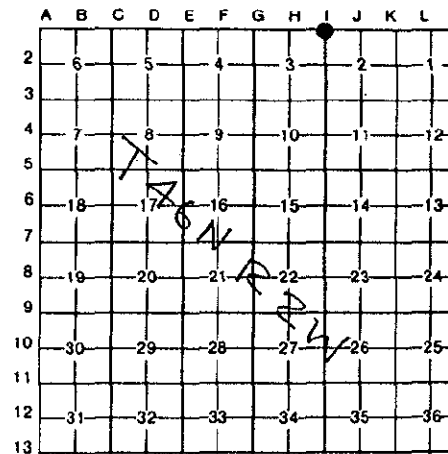

I, William L. Karr, in a field survey on NOVEMBER 3, 19 93, do hereby certify that under requirements of P.A. 74, Michigan P.A. of 1970, the corner points mentioned in lines 1 and 2 above were in conformance with regulations and rules therefore as required in the current manual of survey instructions of the United States Department of the Interior, Bureau of Land Management or by a decree of a Court of Law and/or that the corner points mentioned in lines 3, 4 and 5 above were in conformance with the rules of the Michigan Board of Land Surveyors or by a Decree of a Court of Law; established, re-established, monumented, re-monumented, recovered, found as expressed below:

NOTE: Not more than 4 corners, all in the same town and range, may be recorded on this certificate.

A. Description of original monument and accessories and/or subsequent restoration:

(I-1) Northwest Corner of Section 2 (T46N-R2W)

Subsequent restoration: Corner recorded in Liber 5, Page 224 of Chippewa County records.

Corner is a 1" iron pipe.

Power Pole (E179) S72°E 81.74' 14" W. Birch N65°E 73.29'
12" W. Birch S09°W 43.92'

W.L. Karr set 1/2" x 18" pin with cap #27450 from record witnesses after road construction project in 1985. (Liber 6, Page 366)

Notch in 6" "I" Beam N04°E 19.45' 16" W. Birch N65°E 73.29'
Power Pole (L18/3) S24°E 58.10' 12" W. Birch (Stump) S09°W 43.92'
10" W. Birch S32°W 88.10'

B. Description of corner evidence found and/or method applied in restoring or reestablishing corner:

(I-1) Found corner and all accessories as recorded in Liber 6, Page 366 of the Chippewa County Records. Accepted corner position as found.

C. Description of monument for corner and accessories established to perpetuate locating the position of the corner:

(I-1) Corner is a 1/2" x 18" iron with cap #27450 in a monument box, approximately 2' South of the centerline of Six Mile Road.

Witnesses:

Notch in 6" "I" Beam N04°E 19.45'
16" W. Birch N65°E 73.29'
Power Pole (L18/3) S24°E 58.10'
12" W. Birch (Stump) S09°W 43.92'
10" W. Birch S32°W 88.10'



Signed by William L. Karr Date 7/21/94

Surveyor's Michigan License No. 27450

NOTE: Bearings are compass bearings corrected for declination. Distances are to a nail in side of witness objects unless noted.