

APR 07 1998

LAND CORNER RECORDATION CERTIFICATE  
Filing Requirement of Act 74, Mich. P.A. 1970  
Chippewa County Remonumentation Corner

For corners in

\$2.00 MSSR SECTION

Chippewa Located In: Corner Code #

1. Public Land Survey T 46N R 2W I-2  
T \_\_\_ R \_\_\_  
T \_\_\_ R \_\_\_  
T \_\_\_ R \_\_\_

2. Property Controlling S \_\_\_ T \_\_\_ R \_\_\_  
in Section S \_\_\_ T \_\_\_ R \_\_\_

3. Miscellaneous S \_\_\_ T \_\_\_ R \_\_\_  
Property in Sec. S \_\_\_ T \_\_\_ R \_\_\_

\$7.00 LAND CORNER


12 Mar 1998 12:53:16 PM Receipt #6527  
RECEIVED FOR RECORD  
CHIPPEWA COUNTY - STATE OF MICHIGAN  
SHARON H. KENNEDY, REGISTER OF DEEDS  
BOOK 10 PAGE 236

Register of Deeds Stamp & File Number

4. Lot No. \_\_\_\_\_, Recorded Plat \_\_\_\_\_  
5. Private Claims \_\_\_\_\_

I, William L. Karr, in a field survey on December 3, 1997, do hereby state that under requirements of P.A. 74, Michigan P.A. of 1970, the corner points mentioned in lines 1 and 2 above were in conformance with regulations and rules therefore as required in the current manual of survey instructions of the United States Department of the Interior, Bureau of Land Management or by a decree of a Court of Law and/or that the corner points mentioned in lines 3, 4 and 5 above were in conformance with the rules of the Michigan Board of Land Surveyors or by a Decree of a Court of Law; established, re-established, monumented, recovered, found as expressed below:

**NOTE: Not more than 2 corners, all in the same town and range, may be recorded on this certificate.**

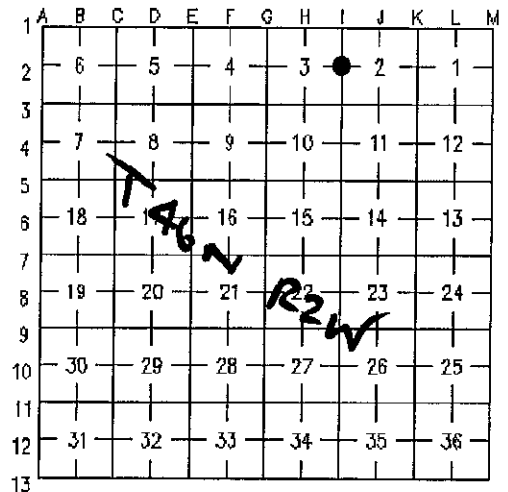

A. Description of original monument and accessories and/or subsequent restoration:

(I-2) 1/4 Corner Common to Sections 2 and 3, T.46 N., R.2 W.  
1849 Harvey Mellen set Y. Birch post in original survey.

Witnesses: Hemlock 14 S35°E 25  
Hemlock 10 N25°W 5

Found no record of subsequent restoration.

B. Description of corner evidence found and/or method applied in restoring or reestablishing corner:

(I-2) 1/4 Corner Common to Sections 2 and 3, T.46 N., R.2 W.

This corner is being perpetuated as part of the Chippewa County Remonumentation Program.

Found no evidence of the original corner or subsequent restoration. Reestablished the corner by single proportionate measurement. Distance North is 2640.55' (meas.), 2637.56' (GLO). Distance South is 2643.20' (meas.), 2640.00' (GLO).




C. Description of monument for corner and accessories established to perpetuate locating the position of the corner:

(I-2) 1/4 Corner Common to Sections 2 and 3, T.46 N., R.2 W.

Corner is a 3/4" x 24" iron with stamped aluminum Chippewa County Remonumentation Corner cap. Placed a metal fence post 1.0' South of corner. Corner falls on edge of an O.R.V. trail.

Witnesses: W. Spruce 5" N54°E 13.62'  
B. Spruce 6" S34°E 44.00'  
Maple 8" S57°W 38.15'  
Aspen 10" N05°W 30.21'

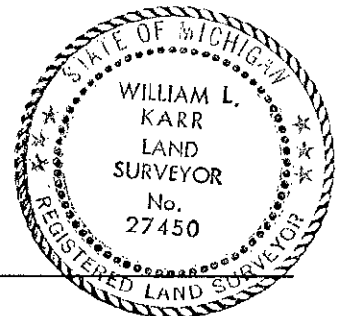

Signed by William L. Karr

Date 12/25/97

Surveyor's Michigan License No. 27450

NOTE: All bearings are compass bearings corrected for declination (6°W). All distances are to a nail and tag in the side of witness object unless otherwise noted.