

APR 07 1998

LAND CORNER RECORDATION CERTIFICATE
Filing Requirement of Act 74, Mich. P.A. 1970
Chippewa County Remonumentation Corner

For corners in


Table with columns: Chippewa, Located In, Corner Code #. Rows include Public Land Survey, Property Controlling in Section, and Miscellaneous Property in Sec.

Register of Deeds Stamp & File Number. Includes amounts (\$7.00 LAND CORNER, \$2.00 NSSR), date (12 Mar 1998), time (12:54:01 PM), receipt # (6527), and book/page (BOOK 10 PAGE 237).

4. Lot No. _____, Recorded Plat _____
5. Private Claims _____

I, William L. Karr, in a field survey on December 2, 1997, do hereby state that under requirements of P.A. 74, Michigan P.A. of 1970, the corner points mentioned in lines 1 and 2 above were in conformance with regulations and rules therefore as required in the current manual of survey instructions of the United States Department of the Interior, Bureau of Land Management or by a decree of a Court of Law and/or that the corner points mentioned in lines 3, 4 and 5 above were in conformance with the rules of the Michigan Board of Land Surveyors or by a Decree of a Court of Law; established, re-established, monumented, recovered, found as expressed below:

NOTE: Not more than 2 corners, all in the same town and range, may be recorded on this certificate.

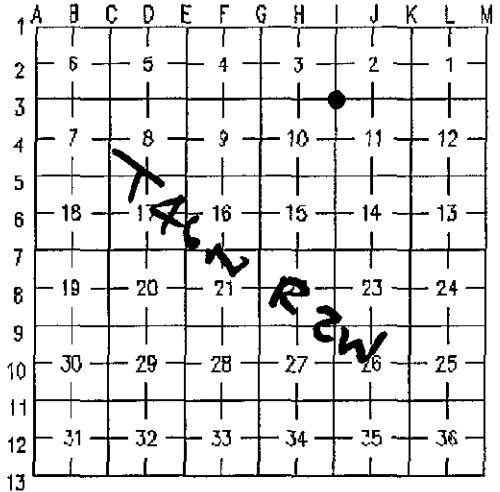

A. Description of original monument and accessories and/or subsequent restoration:

(1-3) Section Corner Common to Sections 2, 3, 10 and 11, T.46 N., R.2 W.
1849 Harvey Mellen set Cedar post in original survey.

Witnesses: Hemlock 18 S57°E 31
Hemlock 18 N47°W 40

Found no record of subsequent restoration.

B. Description of corner evidence found and/or method applied in restoring or reestablishing corner:

(1-3) Section Corner Common to Sections 2, 3, 10 and 11, T.46 N., R.2 W.
This corner is being perpetuated as part of the Chippewa County Remonumentation Program.

Found no evidence of the original corner or subsequent restoration. Reestablished the corner by double proportionate measurement using Section corner 1, 2, 11 and 12 (GLO - 5278.68'; today 5275.10'), 1/4 corner 4 and 9 (GLO - 7933.20'; today - 7927.78), Section corner 2, 3, 34 and 35 (to the North) (GLO 5277.36'; today 5283.83') and 1/4 corner 10 and 11 (GLO - 2640.00'; today - 2643.73'). GLO stream tie to South works well; GLO is 513' to South bank. Distance today is 467.5' to stream centerline.

C. Description of monument for corner and accessories established to perpetuate locating the position of the corner:

(1-3) Section Corner Common to Sections 2, 3, 10 and 11, T.46 N., R.2 W.
Corner is a 3/4" x 24" iron with stamped aluminum Chippewa County Remonumentation Corner cap, 3" above grade. Placed a steel fence post 1.0' North of corner. Corner is approximately 570' West of the Southwest corner of an old clear cut.

Witnesses: Twin Maple 8" N10°E 30.38'
W. Birch 8" S76°E 18.98'
Balsam 10" West 17.62'
Spruce 10" N72°W 27.74'

Signed by [Signature]

Date 12/24/97

Surveyor's Michigan License No. 27450

NOTE: All bearings are compass bearings corrected for declination (6°W). All distances are to a nail and tag in the side of witness object unless otherwise noted.

