

MAY 28 1997

CHIPPEWA COUNTY REMONUMENTATION CORNER

LAND CORNER RECORDATION CERTIFICATE  
Filing Requirement of Act 74, Mich. P.A. 1970

For corners in

\$7.00 LAND CORNER

<u>Chippewa</u> (County)	Located In:	Corner Code #
1. Public Land Survey	T <u>46</u> N R <u>2</u> W	I-5
	T _____ R _____	_____
	T _____ R _____	_____
	T _____ R _____	_____
2. Property Controlling in Section	S _____ T _____ R _____	_____
	S _____ T _____ R _____	_____
3. Miscellaneous Property in Sec.	S _____ T _____ R _____	_____
	S _____ T _____ R _____	_____

\$2.00 MSSR  
3/4/1997 2:35:17 PM Receipt #294  
RECEIVED FOR RECORD  
CHIPPEWA COUNTY - STATE OF MICHIGAN  
SHARON H. KENNEDY, REGISTER OF DEED


BOOK 10 PAGE 89

Register of Deeds Stamp & File Number

4. Lot No. \_\_\_\_\_, Recorded Plat \_\_\_\_\_  
5. Private Claims \_\_\_\_\_

I, William L. Karr, in a field survey on Dec. 18, 1996 do hereby state that under requirements of P.A. 74, Michigan P.A. of 1970, the corner points mentioned in lines 1 and 2 above were in conformance with regulations and rules therefore as required in the current manual of survey instructions of the United States Department of the Interior, Bureau of Land Management or by a decree of a Court of Law and/or that the corner points mentioned in lines 3, 4 and 5 above were in conformance with the rules of the Michigan Board of Land Surveyors or by a Decree of a Court of Law; established, re-established, monumented, recovered, found as expressed below:

NOTE: Not more than 2 corners, all in the same town and range, may be recorded on this certificate.

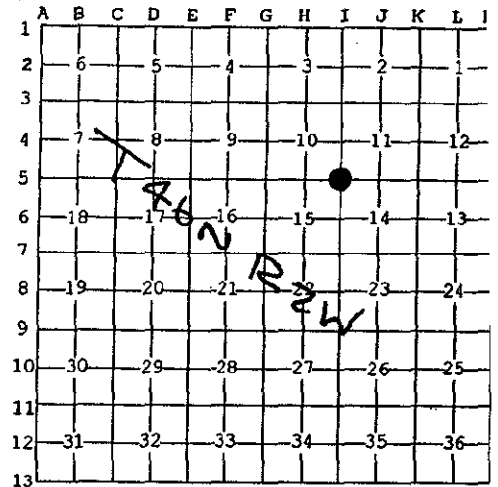

A. Description of original monument and accessories and/or subsequent restoration:


(I-5) Section Corner Common to Sections 10, 11, 14 & 15, T.46 N., R.2 W.

- 1849: H. Mellen set post Witnesses: Spruce 6 S27°E 31 Spruce 6 N32°W 56
- 1914: F.H. Brown, County Surveyor surveyed Section 14 and notes an original corner.
- 1960: R.H. Larsen, County Surveyor established witnesses for this corner and notes corner is on centerline of North-South road and centerline of a road to the East.
- 1982: W.L. Karr, P.S. 27450 found a 3/4" pipe 4' West of North-South road centerline and on centerline of road to the East. (1) witness remained from 1960 witnesses. Corner was accepted & recorded in L.6, Pg.129 of the Chippewa County Corner Records.
- 1995: L.R. Rogers, P.S. 29251 surveyed Section 14 & found this corner disturbed & reset.

B. Description of corner evidence found and/or method applied in restoring or reestablishing corner:

(I-5) This Corner is being perpetuated as part of the Chippewa County Remonumentation Program.

Found no evidence of original corner. Found corner as reset by Rogers in 1995. Monumented corner position as found.

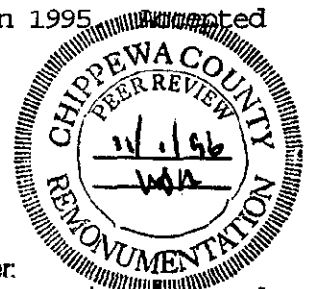

C. Description of monument for corner and accessories established to perpetuate locating the position of the corner:

(I-5) Corner is a 3/4" x 24" iron with plastic Chippewa County Remonumentation Cap and falls 3.5' West of centerline of North-South gravel road and 4' North of extension of centerline of gravel road to East.

Witnesses:	6" Spruce	N39°E	54.33' (existing)
	4" B. Fir	S47°E	44.52'
	7" Spruce	S37°E	78.00'
	10" Tamarack	S85°W	52.80'
	Power pole (DR4/112/13-1)	N58°W	33.21'
	Power pole	N18°W	90.41'



Signed by William L. Karr  
Surveyor's Michigan License No. 27450

Date 12-30-96

NOTE: All bearings are compass bearings corrected for declination. All distances are to a nail in side of witness objects unless noted.